

RECORDED

BERRIEN COUNTY REMONUMENTATION LAND CORNER RECORDATION CERTIFICATE Filing Requirement of Act 74, Mich. P.A. 1970

Nov 29 3 52 PM '95

For corners in

Berrien (County)	Located In:	Corner Code #
1. Public Land Survey	T <u>5S</u> R <u>17W</u>	<u>A-5</u>
	T _____ R _____	_____
	T _____ R _____	_____
	T _____ R _____	_____
2. Property Controlling in Section	S _____ T _____ R _____	_____
	S _____ T _____ R _____	_____
3. Miscellaneous Property in Sec.	S _____ T _____ R _____	_____
	S _____ T _____ R _____	_____

*Berrien County*  
 REGISTER OF DEEDS  
 BERRIEN COUNTY, MICHIGAN

11/29/95 11142015 R66  
 CORNER \$7.00  
 Register of Deeds Stamp & File Number R66  
 STATE PENALTY \$2.00

4. Lot No. \_\_\_\_\_, Recorded Plat \_\_\_\_\_  
 5. Private Claims \_\_\_\_\_

I, Daniel B. Zwar, in a field survey on November 27, 19 95, do hereby certify that under requirements of P.A. 74, Michigan P.A. of 1970, the corner points mentioned in lines 1 and 2 above were in conformance with regulations and rules therefore as required in the current manual of survey instructions of the United States Department of the Interior, Bureau of Land Management or by a decree of a Court of Law and/or that the corner points mentioned in lines 3, 4 and 5 above were in conformance with the rules of the Michigan Board of Land Surveyors or by a Decree of a Court of Law; established, re-established, monumented, re-monumented, recovered, found as expressed below:

	A	B	C	D	E	F	G	H	I	J	K	L	M
2	6	5	4	3	2	1							
3													
4	7	8	9	10	11	12							
5													
6	18	17	16	15	14	13							
7													
8	19	20	21	22	23	24							
9													
10	30	29	28	27	26	25							
11													
12	31	32	33	34	35	36							
13													


NOTE: Not more than 4 corners, all in the same town and range, may be recorded on this certificate.

A. Description of original monument and accessories and/or subsequent restoration:  
 1830 - John Mullet.  
 Set Post. Intersected West Boundary at Post (see M-5) -5-18  
 Beech 28 N57°W - 8 Links  
 W. Ash 24 S16°W - 52 Links  
 GLO calls for no jog

CLAY & ASSOCIATES  
 SURVEYORS  
 MAR 27 1996  
 COMMISSION

B. Description of corner evidence found and/or method applied in restoring or reestablishing corner:  
 November 27, 1995 - Found 3/4" Iron Rod 1.5' North of physical centerline of asphalt pavement. (Naomi Road). All previous witnesses are gone. Found no other physical evidence of corner. From GLO notes there is no N-S jog between this corner and corner M-5 in T.5 S., R. 18 W. They are physically the same monument.  
 1921 - L. Hemingway measured B-5 to A-5 at 2652'  
 1995 - D. Zwar measured B-5 to A-5 at 2651.76'

C. Description of monument for corner and accessories established to perpetuate locating the position of the corner:  
 Removed 3/4" Iron Rod and replaced to exact location with 3/4"X3' iron pipe and BCRP brass cap and monument box set to asphalt grade. Corner is accepted as a careful and faithful perpetuation of the position of the original corner.  
 Witnesses:  
 set nail w/washer in P. Pole #B287-100 S75°E 143.26'  
 set nail w/washer in P. Pole #B287-99 S60°W 64.62'  
 set 3/4" iron pipe N45°E 100.00'  
 set 3/4" iron pipe N45°W 100.00'  
 Center line of existing bit. pavement South 1.5'

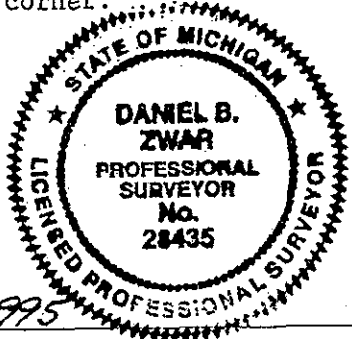

Signed by Daniel B Zwar Date Nov. 29, 1995  
 Surveyor's Michigan License No. 28435