

RATIFIED BY THE BERRIEN COUNTY SURVEY PEER GROUP AS THE OFFICIAL CORNER UNDER MICHIGAN PUBLIC ACT 345 OF 1990

[Signature]
10-23-97
For corners in Berrien (County)

LAND CORNER RECORDATION CERTIFICATE
Filing Requirement of Act 74, Mich. P.A. 1970
Berrien County Remonumentation

97 NOV 10 AM 11:08
BERNICE TRETHERWAY
REGISTER OF DEEDS
BERRIEN COUNTY, MICHIGAN

RECORDED

1. Public Land Survey	T <u>5</u> R <u>17</u>	<u>M2</u>
	T _____ R _____	_____
	T _____ R _____	_____
	T _____ R _____	_____
2. Property Controlling in Section	S _____ T _____ R _____	_____
	S _____ T _____ R _____	_____
3. Miscellaneous Property in Sec.	S _____ T _____ R _____	_____
	S _____ T _____ R _____	_____
4. Lot No. _____, Recorded Plat _____		
5. Private Claims _____		

11/10/97 11143176 A99
CORNER \$7.00
1 Register of Deeds Stamp & File Number A99
STATE REMON FEE \$2.00

I, Dale L. Kesler, in a field survey on September 12, 1997 do hereby state that under requirements of P.A. 74, Michigan P.A. of 1970, the corner points mentioned in lines 1 and 2 above were in conformance with regulations and rules therefore as required in the current manual of survey instructions of the United States Department of the Interior, Bureau of Land Management or by a decree of a Court of Law and /or that the corner points mentioned in lines 3, 4 and 5 above were in conformance with the rules of the Michigan Board of Land Surveyors or by a Decree of a Court of Law; established, re-established, monumented, recovered, found as expressed below:

NOTE: Not more than 2 corners, all in the same town and range, may be recorded on this certificate.

A. Description of original monument and accessories and/or subsequent restoration:

March 17, 1827 William Brookfield set post. Witnesses: 9" Beech S 66 1/4 degrees W 19 lks., 18" Oak N 23 2/3 degrees W 53 lks.

	A	B	C	D	E	F	G	H	I	J	K	L	M
1													
2		6		5		4		3		2		1	
3													
4		7		8		9		10		11		12	
5													
6		18		17		16		15		14		13	
7													
8		19		20		21		22		23		24	
9													
10		30		29		28		27		26		25	
11													
12		31		32		33		34		35		36	
13													

CORNER
REMONUMENTATION

NOV 21 1997

COMMISSION


B. Description of corner evidence found and/or method applied in restoring or reestablishing corner:

Found no evidence of corner. Reestablished corner at the prorated distances and on line between the Southeast and Northeast corner of Section 1, Township 5 South, Range 17 West using Brookfield's 1827 dimensions.

C. Description of monument for corner and accessories established to perpetuate locating the position of the corner:

Set 36" iron pipe with brass plate in a monument box and is accepted as a careful and faithful reestablishment of the position of the original corner.

- PK nail w/washer East side of power pole N 13 degrees 24' W 154.88'
- PK nail w/washer West side of power pole N 16 degrees 10' E 173.38'
- PK nail w/washer 12" walnut S 27 degrees 31' E 22.89'
- PK nail w/ washer East side of power pole S 17 degrees 06' W 111.50'
- East quarter corner Section 6, T5S, R16W, S 50.16'
- Centerline of Road North and South 11.0' W

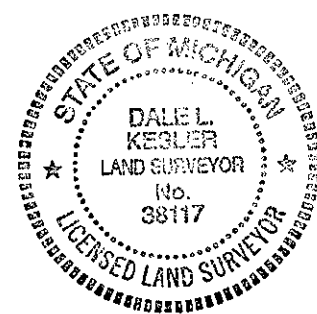

Signed by Dale L. Kesler

Date November 6, 1997

Surveyor's Michigan License No. 38117