

REMONUMENTATION

APR 26 1995

11/08/94

111#6623 A33

CORNER \$7.00

11/08/94

111#6623 A33

STATE REMON FEE \$2.00

COMMISSION

LAND CORNER RECORDATION CERTIFICATE

Filing Requirement of Act 74, Mich. P.A. 1970

BERRIEN COUNTY REMONUMENTATION

RECORDED

NOV 8 4 43 PM '94

REGISTER OF DEEDS
BERRIEN COUNTY MICHIGAN

Register of Deeds Stamp & File Number

RATIFIED BY THE BERRIEN COUNTY SURVEY PEER GROUP AS THE OFFICIAL CORNER UNDER MICHIGAN PUBLIC ACT 346 OF 1990

10-27-94
D.L. Kesler

For Corners in BERRIEN (County)

Located In: Corner Code #

| | | | | | |
|------------------------------------|---|---|---|----|-----|
| 1. Public Land Survey | T | 5 | R | 17 | M-5 |
| | T | | R | | |
| | T | | R | | |
| | T | | R | | |
| 2. Property Controlling in Section | S | | T | | R |
| | S | | T | | R |
| 3. Miscellaneous Property in Sec. | S | | T | | R |
| | S | | T | | R |

4. Lot No. _____, Recorded Plat _____
5. Private Claims _____

I, Dale L. Kesler, in a field survey on November 2, 1994

do hereby certify that under requirements of P.A. 74, Michigan P.A. of 1970, the corner points mentioned in lines 1 and 2 above were in conformance with regulations and rules therefore as required in the current manual of survey instructions of the United States Department of the Interior, Bureau of Land Management or by a decree of a Court of Law and/or that the corner points mentioned in lines 3, 4 and 5 above were in conformance with the rules of the Michigan Board of Land Surveyors or by a Decree of a Court of Law; established, re-established, monumented, re-monumented, recovered, found as expressed below:

NOTE: Not more than 4 corners, all in the same town and range, may be recorded on this certificate.

| A | B | C | D | E | F | G | H | I | J | K | L | M |
|----|----|----|----|----|----|----|---|---|---|---|---|---|
| 2 | 6 | 5 | 4 | 3 | 2 | 1 | | | | | | |
| 3 | | | | | | | | | | | | |
| 4 | 7 | 8 | 9 | 10 | 11 | 12 | | | | | | |
| 5 | | | | | | | | | | | | |
| 6 | 16 | 17 | 18 | 15 | 14 | 13 | | | | | | |
| 7 | | | | | | | | | | | | |
| 8 | 19 | 20 | 21 | 22 | 23 | 24 | | | | | | |
| 9 | | | | | | | | | | | | |
| 10 | 30 | 29 | 28 | 27 | 26 | 25 | | | | | | |
| 11 | | | | | | | | | | | | |
| 12 | 31 | 32 | 33 | 34 | 35 | 36 | | | | | | |
| 13 | | | | | | | | | | | | |

A. Description of original monument and accessories and/or subsequent restoration:

1827 - William Brookfield set post, accessories 14" Beech - south 6 links, 8" Beech N. 53° W. 22 links; 1916 - Dewey found stone, accessories, Stone for Cass County - South 43.0', 12" Sycamore NE 35 feet, 10" Elm SE 34 feet, 6" Walnut S. 10° W. 29.0'


B. Description of corner evidence found and/or method applied in restoring or reestablishing corner:

Found stone 48" deep, found old 10" Elm witness, now stump measured 34' to stone. Accepted stone as best evidence of corner.

C. Description of monument for corner and accessories established to perpetuate locating the position of the corner:

Set standard 3' long pipe with brass plate over stone in monument box and is accepted as a careful and faithful perpetuation of the original corner.

Set nail w/witness tag in 22" Walnut N. 05° E. 27.12'
Set nail w/witness tag in 18" Walnut S. 40° E. 17.26'
Set nail w/witness tag in 16" Elm S. 70° W. 35.69'
Found 1" pipe in asphalt road South 41.92'

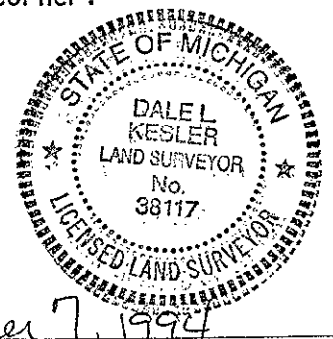

Signed by Dale L. Kesler Date November 7, 1994

Surveyor's Michigan License No. No. 38117