

LAND CORNER RECORDATION CERTIFICATE
Filing Requirement of Act 74, Mich. P.A. 1970

For corners in
Berrien
County

	Located In:	Corner Code #
1. Public Land Survey	T 55 R 18W	F10
	T 55 R 18W	G10
	T R	
	T R	
2. Property Controlling in Section	S T R	
	S T R	
3. Miscellaneous Property in Sec.	S T R	
	S T R	

Register of Deeds Stamp & File Number

4. Lot No. _____, Recorded Plat _____
 5. Private Claims _____

	A	B	C	D	E	F	G	H	I	J	K	L	M
2	6	5	4	3	2	1							
3													
4	7	8	9	10	11	12							
5													
6	18	17	16	15	14	13							
7													
8	19	20	21	22	23	24							
9													
10	30	29	28	27	26	25							
11													
12	31	32	33	34	35	36							
13													

G10 May 13, 1991
 I, Gary C. Bilow, in a field survey on F10 May 15, 1991, 19____, do hereby certify that under requirements of P.A. 74, Michigan P.A. of 1970, the corner points mentioned in lines 1 and 2 above were in conformance with regulations and rules therefore as required in the current manual of survey instructions of the United States Department of the Interior, Bureau of Land Management or by a decree of a Court of Law and/or that the corner points mentioned in lines 3, 4 and 5 above were in conformance with the rules of the Michigan Board of Land Surveyors or by a Decree of a Court of Law, established, re-established, monumented, re-monumented, recovered, found as expressed below.

NOTE: Not more than 4 corners, all in the same town and range, may be recorded on this certificate.

A. Description of original monument and accessories and/or subsequent restoration:


F10: Corner not established by Government Land Office Survey. Survey records obtained from Wightman & Associates, Inc. reference this corner in 1948, 1954, 1960, & 1966. In 1966 records indicate a stone in a Monument box - accessories: S20E 51.6', Power Pole; North 58.1', Power Pole; Southeast 51.6' Elec. Pole; S35W 41.7', 6" Peach.
 G10: Post established by U.S. Government Deputy Surveyor L. Lyon in 1829 - accessories: Elm 16, S72E 44 links & Beech 24, N27W 16 links. Survey records obtained from Wightman & Associates, Inc. reference this corner in Books 7 and 134 in 1948, 1954, 1960, & 1966. The 1966 reference indicates an Iron and Monument box - accessories: Southwest corner porch, N30E 76.9'; 24" Maple, N50E 87.9'; Twin 24" Oak, North 75.7'; & Iron, North 33.0'.

B. Description of corner evidence found and/or method applied in restoring or reestablishing corner:

F10: Found 1" Iron pipe in Monument Box. Recovered one (1) witness from Wightman notes. Distance to adjacent corners were reasonable and consistent. Accepted iron as the best evidence of the original GLO corner.
 G10: Found 3/4" Iron pipe in Monument box. No accessories were recovered. Distances to adjacent corners were reasonable and consistent. Accepted this iron as the best evidence of the original GLO corner.

C. Description of monument for corner and accessories established to perpetuate locating the position of the corner:

F10: Found 1" Iron pipe in Monument Box	G10: Found 3/4" Iron pipe in Monument box
S32E 51.94', N&T in Telephone Pole	N32E 32.20', PK in 8" Hackberry
N67E 59.15', N&T in 35" Maple	S72E 76.51', N&T in 52" Stump
N1W 29.1', Center top telephone box	S33W 29.39', N&T in 3" Quad Maple
S3W 90.57', N&T in 18" Cherry	S79E 87.53', N&T in 12" Elm

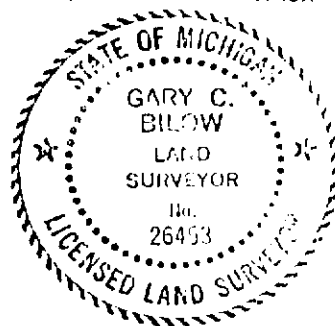

Signed by Gary C. Bilow Date 3/31/92
 Surveyor's Michigan License No. 26453