

**SURVEY & REMONUMENTATION**

DEC 08 1993

11/29/93

111#2802

A33

11/29/93

CORNER

\$7.00

111#2802

A33

STATE REMON FEE \$2.00

**BERRIEN CO. REMONUMENTATION  
LAND CORNER RECORDATION CERTIFICATE  
Filing Requirement of Act 74, Mich. P.A. 1970**

For corners in  
**Berrien**

(County)

Located In:

Corner Code --#

1. Public Land Survey	T <u>5S</u> R <u>18W</u>	A-8
	T _____ R _____	_____
	T _____ R _____	_____
	T _____ R _____	_____
2. Property Controlling in Section	S _____ T _____ R _____	_____
	S _____ T _____ R _____	_____
3. Miscellaneous Property in Sec.	S _____ T _____ R _____	_____
	S _____ T _____ R _____	_____

REGISTER OF DEEDS  
 REGISTERED  
 NOV 29 10 21 AM '93

NOV 29 10 21 AM '93

RECORDED

Register of Deeds Stamp & File Number

4. Lot No. \_\_\_\_\_, Recorded Plat \_\_\_\_\_  
 5. Private Claims \_\_\_\_\_

	A	B	C	D	E	F	G	H	I	J	K	L	M
2	6		5		4		3		2		1		
3													
4	7		8		9		10		11		12		
5													
6	18		17		16		15		14		13		
7													
8	19		20		21		22		23		24		
9													
10	30		29		28		27		26		25		
11													
12	31		32		33		34		35		36		
13													

I, Donald R. Pitts, Jr., in a field survey on November 15, 1993, do hereby certify that under requirements of P.A. 74, Michigan P.A. of 1970, the corner points mentioned in lines 1 and 2 above were in conformance with regulations and rules therefore as required in the current manual of survey instructions of the United States Department of the Interior, Bureau of Land Management or by a decree of a Court of Law and/or that the corner points mentioned in lines 3, 4 and 5 above were in conformance with the rules of the Michigan Board of Land Surveyors or by a Decree of a Court of Law; established, re-established, monumented, re-monumented, recovered, found as expressed below:

**NOTE: Not more than 4 corners, all in the same town and range, may be recorded on this certificate.**

A. Description of original monument and accessories and/or subsequent restoration:  
A-8 1/4 Post Section 19, T5S, R18W

Corner not established by original government surveyors.  
 1972 - Wightman and Associates - Stone in Mon Box  
 1993 - D.R. Pitts Jr. - Stone in Mon Box

B. Description of corner evidence found and/or method applied in restoring or reestablishing corner:  
A-8 1/4 Post Section 19, T5S, R18W


Found Stone in Mon Box. Found P.K. nail T5S, R19W, M-8 South 19.45'. This position not established by original government surveyors. This monument is accepted as the best available evidence of the position of the corner, as ratified by the Berrien County Remonumentation Program Peer Group on November 19, 1993.

C. Description of monument for corner and accessories established to perpetuate locating the position of the corner:

A-8 1/4 Post Sections 19, T5S, R18W

10" Long Iron Pipe with Berrien Co. Remon. Brass Cap over Stone in Mon Box with Mortar.  
 Nail & Wit Tag in E. Side Power Pole B297 33 N25°W 61.70'  
 Nail & Wit Tag in S. Side 20" Spruce N75°E 31.97'  
 Nail & Wit Tag in E. Side Power Pole B297-34 S10°W 144.78'  
 36" Long Iron Pipe with Berrien Co. Remon. Brass Cap in Mon Box T5S, R19W M-8 South 19.29'

Signed by Donald R. Pitts  
 Surveyor's Michigan License No. 25867

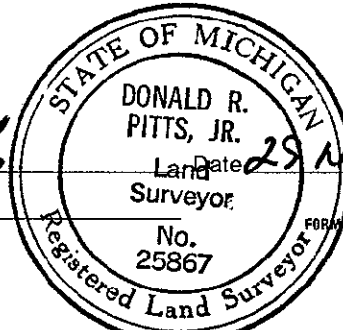

Date 29 November 1993

FORM APPROVED BY MICHIGAN STATE BOARD OF LAND SURVEYORS, JAN. 28, 1971  
 REVISED MAY 14, 1975  
 REVISED JAN., 1983