

DEC 08 1993

COMMISSION

11/29/93

111#2802

A33

11/29/93

CORNER

\$7.00

111#2802

A33

STATE REMON FEE \$2.00

BERRIEN CO. REMONUMENTATION  
LAND CORNER RECORDATION CERTIFICATE  
Filing Requirement of Act 74, Mich. P.A. 1970

For corners in

Berrien

(County)

Located In:

Corner Code #

- 1. Public Land Survey      T 5S R 18W      A-11
- T \_\_\_\_\_ R \_\_\_\_\_      \_\_\_\_\_
- T \_\_\_\_\_ R \_\_\_\_\_      \_\_\_\_\_
- T \_\_\_\_\_ R \_\_\_\_\_      \_\_\_\_\_
- 2. Property Controlling    S \_\_\_\_\_ T \_\_\_\_\_ R \_\_\_\_\_      \_\_\_\_\_
- in Section               S \_\_\_\_\_ T \_\_\_\_\_ R \_\_\_\_\_      \_\_\_\_\_
- 3. Miscellaneous           S \_\_\_\_\_ T \_\_\_\_\_ R \_\_\_\_\_      \_\_\_\_\_
- Property in Sec.         S \_\_\_\_\_ T \_\_\_\_\_ R \_\_\_\_\_      \_\_\_\_\_

- 4. Lot No. \_\_\_\_\_, Recorded Plat \_\_\_\_\_
- 5. Private Claims \_\_\_\_\_

Berrien County  
 REGISTER OF DEEDS  
 RECEIVED  
 NOV 29 10 22 AM '93

Register of Deeds Stamp & File Number

	A	B	C	D	E	F	G	H	I	J	K	L	M
2	6		5		4		3		2		1		
3													
4	7		8		9		10		11		12		
5													
6	18		17		16		15		14		13		
7													
8	19		20		21		22		23		24		
9													
10	30		29		28		27		26		25		
11													
12	31		32		33		34		35		36		
13													

I, Donald R. Pitts, Jr. in a field survey on November 15, 19 93  
do hereby certify that under requirements of P.A. 74, Michigan P.A. of 1970, the corner points mentioned in lines 1 and 2 above were in conformance with regulations and rules therefore as required in the current manual of survey instructions of the United States Department of the Interior, Bureau of Land Management or by a decree of a Court of Law and/or that the corner points mentioned in lines 3, 4 and 5 above were in conformance with the rules of the Michigan Board of Land Surveyors or by a Decree of a Court of Law; established, re-established, monumented, re-monumented, recovered, found as expressed below:

NOTE: Not more than 4 corners, all in the same town and range, may be recorded on this certificate.

A. Description of original monument and accessories and/or subsequent restoration:

- A-11 Section Corner 30 & 31, T5S, R18W
- 1829 August - Deputy Surveyor Lucius Lyon Intersected W. Boundary
- 32 N. of Post Willow 9 N80E 186
- 1980 - M.R. Rushlow - Railroad Spike
- 1985 & 1991 - J.G. Kamer - Railroad Spike
- 1990 - D.R. Pitts Jr. - Railroad Spike


B. Description of corner evidence found and/or method applied in restoring or reestablishing corner:

- A-11 Section Corner 30 & 31, T5S, R18W
- Found Railroad Spike. Found Plug in Mon Box T5S, R19W, M-11 South 21.10', and is accepted as a careful and faithful reestablishment of the position of the original corner, and ratified by the Berrien County Remonumentation Program Peer Group on November 8, 1993

C. Description of monument for corner and accessories established to perpetuate locating the position of the corner:

- A-11 Section Corner 30 & 31, T5S, R18W
- 36" Long Iron Pipe with Berrien Co. Remon. Brass Cap in Mon Box.
- Nail & Wit Tag in N.E. Side Power Pole B315-112 N50°W 35.41'
- Nail & Wit Tag in S.E. Side Power Pole B333-89 S30°W 66.76'
- Nail & Wit Tag in S.W. Side Power Pole B334-38 S30°E 65.62'
- 36" Long Iron Pipe with Berrien Co. Remon. Brass Cap in Mon Box, T5S, R19W M-11 South 21.10'

Signed by Donald R. Pitts Jr.  
 Surveyor's Michigan License No. 25867

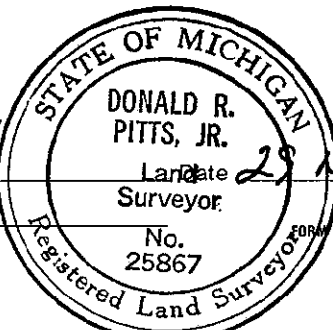

29 November 1993