

RATIFIED BY THE BERRIEN COUNTY
SURVEY PEER GROUP AS THE
OFFICIAL CORNER UNDER MICHIGAN
PUBLIC ACT 345 OF 1990

**Berrien County Remonumentation Program
LAND CORNER RECORDATION CERTIFICATE**

RECORDED

00 NOV -8 PM 12:51

7-06-00

Filing Requirement of Act 74, Mich. P.A. 1970

JENNICE TRETHERWAY
REGISTER OF DEEDS
BERRIEN COUNTY, MICHIGAN

11/08/00 111#6048 A66
CORNER \$7.00
11/08/00 111#6048 A66
STATE REMON FEE \$2.00

Register of Deeds Stamp & File
Number

For corners in

Berrien (County)	Located In:	Corner Code #
1. Public Land Survey	T <u>5S</u> R <u>18W</u>	<u>K-1</u>
	T ___ R ___	___
	T ___ R ___	___
	T ___ R ___	___
2. Property Controlling in Section	S ___ T ___ R ___	___
	S ___ T ___ R ___	___
3. Miscellaneous Property in Sec.	S ___ T ___ R ___	___
	S ___ T ___ R ___	___

4. Lot No. _____, Recorded Plat _____
5. Private Claims _____

I, Alan K. Bartlett, in a field survey on March 29, 2000 do hereby state that under requirements of P.A. 74, Michigan P.A. of 1970, the corner points mentioned in lines 1 and 2 above were in conformance with regulations and rules therefore as required in the current manual of survey instructions of the United States Department of the Interior, Bureau of Land Management or by a decree of a Court of Law and /or that the corner points mentioned in lines 3, 4 and 5 above were in conformance with the rules of the Michigan Board of Land Surveyors or by a Decree of a Court of Law; established, re-established, monumented, recovered, found as expressed below:

NOTE: Not more than 2 corners, all in the same town and range, may be recorded on this certificate.

A. Description of original monument and accessories and/or subsequent restoration:

- 1830- GLO- JOHN MULLETT; NORTH BETWEEN SECTIONS 1 & 2 80.44 CHAINS INTERSECTED NORTH BOUNDARY 39 LINKS EAST OF POST SET CORNER TO SECTIONS 1 & 2. WITNESSES: S63°E 6 LINKS 8" DO, S42°W 17 LINKS 9" BEECH.
- 1972- SOUTHWEST SURVEY-ALTON HOWARD; ½ MILE DISTANCE TO THE EAST =2622.20', ½ MILE DISTANCE TO THE SOUTH =2652.18', ANGLE IN THE SOUTHEAST QUADRANT 89°17'40". WITNESSES: N45°E 45.90' POWER POLE, S10°W 15.86' CONCRETE WING WALL, WEST 25.70' IRON BOLT, N65°W 60.58' POWER POLE.
- 1994- WIGHTMAN & ASSOCIATES- J. KAMER; 5/8" IRON ROD. WITNESSES: S35°E 42.07' PK IN 6" PEAR, S50°E 53.74' PK IN 6" PEAR, WEST 25.76' IRON IN MONUMENT BOX (SOUTHWEST CORNER SEC 36-14S-R18W), N75°W 60.91' PK IN WOOD POST

B. Description of corner evidence found and/or method applied in restoring or reestablishing corner:

FOUND 5/8" REBAR IN IRON PIPE OVER STONE. VERIFIED CORNER WITH EXISTING WITNESSES.
THIS CORNER APPROVED BY THE BERRIEN COUNTY REMONUMENTATION PEER GROUP OF SURVEYORS

C. Description of monument for corner and accessories established to perpetuate locating the position of the corner:


SET 3' LONG IRON PIPE WITH BRASS CAP (MARKED 2000 & 35988) REMOVED STONE.
THIS POSITION NOT ESTABLISHED BY ORIGINAL GOVERNMENT SURVEYORS. THIS MONUMENT IS ACCEPTED AS THE BEST AVAILABLE EVIDENCE OF THE POSITION OF THE CORNER.

- Witnesses:
- S20°E 41.70' 9" PEAR TREE
 - S40°E 53.45' 9" PEAR TREE
 - S41°W 89.78' POWER POLE WITH MDOT FLASHER
 - WEST 25.72' K-13-SOUTHWEST CORNER OF SECTION 36-REMONUMENTED
 - N60°W 60.94' UTILITY POLE WITH MDOT FLASHER

Signed by Alan K. Bartlett Date 11/02/00

Surveyor's Michigan License No. 35988

	A	B	C	D	E	F	G	H	I	J	K	L	M
1													
2	6			5			4			3		2	1
3													
4	7						8			9		10	11
5													
6	18						17			16		15	14
7													
8	19						20			21		22	23
9													
10	30						29			28		27	26
11													
12	31						32			33		34	35
13													
14													

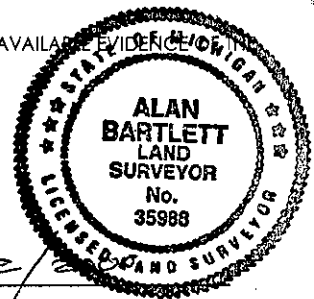

**SURVEY &
REMONUMENTATION**

FORM APPROVED BY MICHIGAN STATE BOARD OF PROFESSIONAL SURVEYORS, JAN. 28, 1971
REVISED MAY 14, 1975
REVISED JAN., 1983
REVISED OCT., 1995

JAN 31 2001

LIBER 4

PAGE 237

SECTION