

FILED BY THE BERRIEN COUNTY SURVEY PEER GROUP AS THE OFFICIAL CORNER UNDER MICHIGAN PUBLIC ACT 345 OF 1990

RECORDED

BERRIEN COUNTY REMONUMENTATION LAND CORNER RECORDATION CERTIFICATE Filing Requirement of Act 74, Mich. P.A. 1970

Nov 29 3 53 PM '95

For corners in

Daniel B. Zwar
REGISTER OF DEEDS
BERRIEN COUNTY MICHIGAN

| For corners in | Located In: | Corner Code # |
|------------------------------------|--------------------------|---------------|
| <u>Berrien</u> (County) | | |
| 1. Public Land Survey | T <u>5S</u> R <u>18W</u> | <u>M-5</u> |
| | T _____ R _____ | _____ |
| | T _____ R _____ | _____ |
| | T _____ R _____ | _____ |
| 2. Property Controlling in Section | S _____ T _____ R _____ | _____ |
| | S _____ T _____ R _____ | _____ |
| 3. Miscellaneous Property in Sec. | S _____ T _____ R _____ | _____ |
| | S _____ T _____ R _____ | _____ |

11/29/95 111W2015 A66
CORNER \$7.00
11/29/95 111W2015 A66
STATE REMON FEE \$2.00
Register of Deeds Stamp & File Number

4. Lot No. _____, Recorded Plat _____
5. Private Claims _____

| | A | B | C | D | E | F | G | H | I | J | K | L | M |
|----|----|---|----|---|----|---|----|---|----|---|----|---|---|
| 2 | 6 | | 5 | | 4 | | 3 | | 2 | | 1 | | |
| 3 | | | | | | | | | | | | | |
| 4 | 7 | | 8 | | 9 | | 10 | | 11 | | 12 | | |
| 5 | | | | | | | | | | | | | |
| 6 | 18 | | 17 | | 16 | | 15 | | 14 | | 13 | | |
| 7 | | | | | | | | | | | | | |
| 8 | 19 | | 20 | | 21 | | 22 | | 23 | | 24 | | |
| 9 | | | | | | | | | | | | | |
| 10 | 30 | | 29 | | 28 | | 27 | | 26 | | 25 | | |
| 11 | | | | | | | | | | | | | |
| 12 | 31 | | 32 | | 33 | | 34 | | 35 | | 36 | | |
| 13 | | | | | | | | | | | | | |

I, Daniel B. Zwar, in a field survey on November 27, 19 95, do hereby certify that under requirements of P.A. 74, Michigan P.A. of 1970, the corner points mentioned in lines 1 and 2 above were in conformance with regulations and rules therefore as required in the current manual of survey instructions of the United States Department of the Interior, Bureau of Land Management or by a decree of a Court of Law and/or that the corner points mentioned in lines 3, 4 and 5 above were in conformance with the rules of the Michigan Board of Land Surveyors or by a Decree of a Court of Law; established, re-established, monumented, re-monumented, recovered, found as expressed below:

NOTE: Not more than 4 corners, all in the same town and range, may be recorded on this certificate.

A. Description of original monument and accessories and/or subsequent restoration:

1827 - William Brookfield No BCRC witnesses
Book 1 Page 408 1972 A.L. Pyle for NE corner Sec. 13-5-18
Set Post L.C.R.C. witnesses Liber 1 pages 189 & 190
Beech 28 N57°W - 8 Links iron in center of road
W. Ash 24 S16°W - 52 Links SW 54.5' to Elec. Pole
NE 26.8' to 12" Apple Tree
NE 73.3' to 6" Apple Tree

1973 - ER Stefan for NE corner Sec. 13-5-18 used but refers to PYLE witnesses

B. Description of corner evidence found and/or method applied in restoring or reestablishing corner:

November 27, 1995 - Found 3/4" Iron Rod - 1.5' North of physical centerline of asphalt pavement (Naomi Road). All previous witnesses are gone. Found no stone or other physical evidence of corner. From original GLO notes there is no N-S jog between this corner and corner A-5 in T.5S., R.17W. They are therefore physically the same monument.

SURVEY & DOCUMENTATION

MAR 27 1996


COMMISSION

C. Description of monument for corner and accessories established to perpetuate locating the position of the corner:

Removed 3/4" Iron Rod and replaced to exact location with 3/4"X3' iron pipe and BCRP brass cap and monument box set to asphalt grade. Corner is accepted as a careful and faithful perpetuation of the position of the original corner.

Witnesses:

set nail w/washer in P. Pole #B287-100 S75°E 143.26'
set nail w/washer in P. Pole #B287-99 S60°W 64.62'
set 3/4" iron pipe N45°E 100.00'
set 3/4" iron pipe N45°W 100.00'
Center line of existing bit. pavement South 1.5'

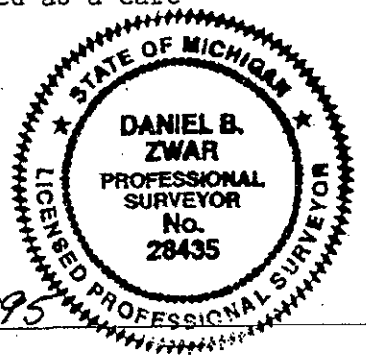

Signed by Daniel B. Zwar Date Nov. 29, 1995
Surveyor's Michigan License No. 28435