

RA...ED BY THE BERRIEN COUNTY
 SURVEY PEER GROUP AS THE
 OFFICIAL CORNER UNDER MICHIGAN
 PUBLIC ACT 849 OF 1990
Warren D. DeW
 4-25-95

11/29/95 111#2012 A77
 11/29/95 111#2012 49600
 STATE RECORDS FEE \$4.00

BERRIEN COUNTY REMONUMENTATION
 LAND CORNER RECORDATION CERTIFICATE
 Filing Requirement of Act 74, Mich. P.A. 1970

For corners in

BERRIEN Located In: Corner Code #/ #
 (County)

1. Public Land Survey T 6S R 17W A-1
 Comment: T55 R17W A13
 T55, R18W, M13
 T65, R18W, M1
 T R
 T R
 T R

2. Property Controlling S T R
 in Section S T R
 3. Miscellaneous S T R
 Property in Sec. S T R

4. Lot No. _____, Recorded Plat _____
 5. Private Claims _____

RECORDED
 Nov 29 3 39 PM '95
Barbara J. ...
 REGISTER OF DEEDS
 BERRIEN COUNTY MICHIGAN
 Register of Deeds Stamp & File Number

I, JOHN G. KAMER, in a field survey on NOVEMBER 17, 19 95
 do hereby certify that under requirements of P.A. 74, Michigan P.A. of 1970, the corner points mentioned
 in lines 1 and 2 above were in conformance with regulations and rules therefore as required in the
 current manual of survey instructions of the United States Department of the Interior, Bureau of Land
 Management or by a decree of a Court of Law and/or that the corner points mentioned in lines 3, 4 and 5
 above were in conformance with the rules of the Michigan Board of Land Surveyors or by a Decree of a
 Court of Law; established, re-established, monumented, re-monumented, recovered, found as
 expressed below:

| | | | | | | | | | | | | |
|----|----|----|----|----|----|----|---|---|---|---|---|---|
| A | B | C | D | E | F | G | H | I | J | K | L | M |
| 2 | 6 | 5 | 4 | 3 | 2 | 1 | | | | | | |
| 3 | | | | | | | | | | | | |
| 4 | 7 | 8 | 9 | 10 | 11 | 12 | | | | | | |
| 5 | | | | | | | | | | | | |
| 6 | 18 | 17 | 16 | 15 | 14 | 13 | | | | | | |
| 7 | | | | | | | | | | | | |
| 8 | 19 | 20 | 21 | 22 | 23 | 24 | | | | | | |
| 9 | | | | | | | | | | | | |
| 10 | 30 | 29 | 28 | 27 | 26 | 25 | | | | | | |
| 11 | | | | | | | | | | | | |
| 12 | 31 | 32 | 33 | 34 | 35 | 36 | | | | | | |
| 13 | | | | | | | | | | | | |

NOTE: Not more than 4 corners, all in the same town and range, may be recorded
 on this certificate.

A. Description of original monument and accessories and/or subsequent restoration:
 (SEE BACK.)

SURVEY &
 MONUMENTATION
 MAR 27 1996
 COMMISSION


B. Description of corner evidence found and/or method applied in restoring or reestablishing corner:

FOUND IRON AT FENCE INTERSECTION PER 1930± SURVEY NOTES. THE PERPETUATION OF THE CORNER AS EVIDENCED
 BY THE WITNESS TIES APPEARS RELIABLE AND ACCURATE.

C. Description of monument for corner and accessories established to perpetuate locating the position of the corner:

REMOVED 2' X 1 1/2" IRON PIPE
 SET STANDARD 3' X 4" CONCRETE MONUMENT WITH BRASS PLATE. ALSO SET CARSONITE MARKER IN VICINITY OF CORNER.
 SET NAIL W/TAG IN 16" TULIP S50° E 22.72'
 SET NAIL W/TAG IN 18" TULIP S40° E 24.30'
 SET NAIL W/TAG IN 16" CHERRY S25° E 25.16'
 SET NAIL W/TAG IN 36" STUMP N60° E 12.22'
 CORNER IS ACCEPTED AS A CAREFUL AND FAITHFUL PERPETUATION OF THE POSITION OF THE ORIGINAL CORNER.

Signed by *John G. Kamer*
 Surveyor's Michigan License No. 27449

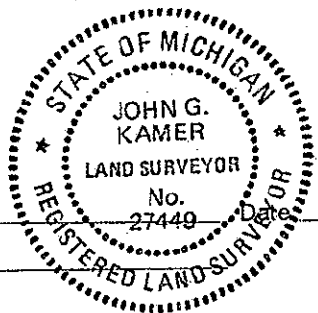

11-29-95
 FORM APPROVED BY MICHIGAN STATE BOARD OF LAND SURVEYORS, JAN. 28, 1971
 REVISED MAY 14, 1975
 REVISED JAN., 1983

**Berrien Township (T 6 S, R 17 W)
NW Cor. Sec. 6 (A-1)**

March 15, 1827

William Brookfield, D.S.
(From East) 82.00 Set @ Cor. to Towns 5 & 6 South
Ranges 17 & 18 West
Beech 9 S 35½ E 22
Beech 14 N 22½ W 19

1930±

Notes on file @ W&A
No Jog - Fence Corner at Corner
Surveyed Surrounding Parcels

April 2, 1973

Richard Garrett @ W&A, LCRC, Liber 1, page 292
⅝" Bolt in Mon. Box
Utility Pole S 45° W 48.25'
Light Pole S 45° E 40.35'
St. Sign Pole N 45° E 44.30'

Nov. 6, 1975

E.R. Stefan
Point Found - No Witnesses

March 22, 1988

May 4, 1988

Sept. 26, 1988

Nov. 22, 1989

Kamer @ W&A
NW Cor. 6-6-18
Fd. Iron
16" Oak S 60° E 22.8'
20" Oak S 45° E 24.4'
At Intersection of Fence Lines South and West
Strebs @ W&A
Northeast Corner
Sec. 1-6-18
(Fnd. 1 ¼" Iron Pipe at Intersection of Fences)
PK Nail in 16" Tulip S 50° E 22.86'
PK Nail in 18" Tulip S 45° E 24.48'
PK Nail in 16" Cherry S 35° E 25.20'
PK Nail in 36" Stump N 40° E 12.10'

Sept. 24, 1991

Nov. 6, 1991