


Lincoln Twp

Meander corners

1993

Town 5 South Range 19 West

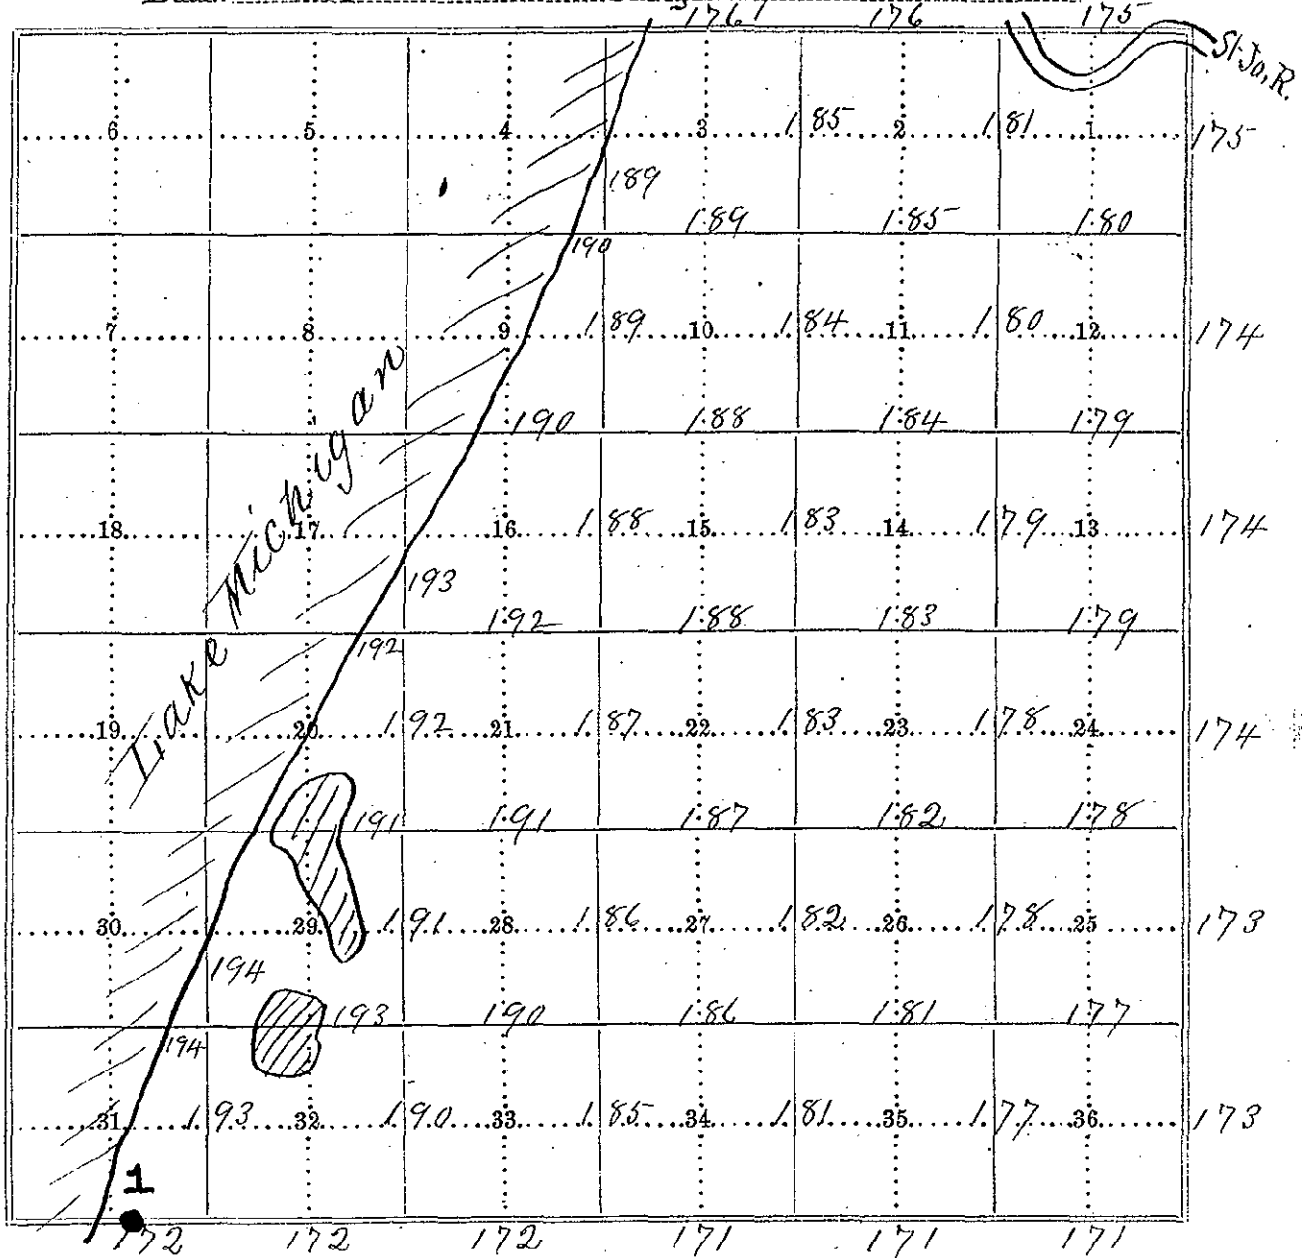

Meanders on Pages 194 to 197

State

SURVEY & REMONUMENTATION

NOV 21 1996

COMMISSION

Berrien Co.