

SURVEY & REMONUMENTATION

DEC 08 1993

COMMISSION

**BERRIEN CO. REMONUMENTATION
LAND CORNER RECORDATION CERTIFICATE
Filing Requirement of Act 74, Mich. P.A. 1970**

RECORDED

Nov 17 1 43 PM '93

Barrie T. ...
REGISTER OF DEEDS
BERRIEN COUNTY MICHIGAN

For corners in

Berrien

(County)

Located In:

Corner Code #

1. Public Land Survey	T	5S	R	19W	M-9
	T	5S	R	19W	M-10
	T		R		
	T		R		
2. Property Controlling in Section	S		T	R	
	S		T	R	
3. Miscellaneous Property in Sec.	S		T	R	
	S		T	R	

Register of Deeds Stamp & File Number

4. Lot No. _____, Recorded Plat _____
5. Private Claims _____

I, Donald R. Pitts, Jr., in a field survey on November 15, 1993, do hereby certify that under requirements of P.A. 74, Michigan P.A. of 1970, the corner points mentioned in lines 1 and 2 above were in conformance with regulations and rules therefore as required in the current manual of survey instructions of the United States Department of the Interior, Bureau of Land Management or by a decree of a Court of Law and/or that the corner points mentioned in lines 3, 4 and 5 above were in conformance with the rules of the Michigan Board of Land Surveyors or by a Decree of a Court of Law; established, re-established, monumented, re-monumented, recovered, found as expressed below:

NOTE: Not more than 4 corners, all in the same town and range, may be recorded on this certificate.

	A	B	C	D	E	F	G	H	I	J	K	L	M
2	6	5		4	3				2	1			
3													
4	7	8	9	10	11	12							
5													
6	18	17	16	15	14	13							
7													
8	19	20	21	22	23	24							
9													
10	30	29	28	27	26	25							
11													
12	31	32	33	34	35	36							
13													


A. Description of original monument and accessories and/or subsequent restoration:

- M-9 Original Government Surveyor set post
- M-10 Original Government Surveyor set post

11/17/93	111#2096	A66
	CORNER	\$7.00
11/17/93	111#2096	A66
	STATE REMON FEE	\$2.00

B. Description of corner evidence found and/or method applied in restoring or reestablishing corner:

- M-9 Found State of Michigan Monument in Mon. Box
State of Michigan Monument in Mon Box T5S, R19W A-9 North 22.73'
- M-10 Found Iron Pipe in Concrete in Mon Box
R.R. Spike T5S R18W A-10 North 21.71'

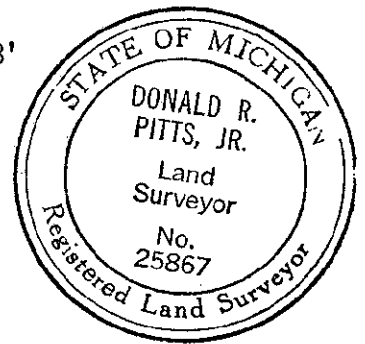

C. Description of monument for corner and accessories established to perpetuate locating the position of the corner:

- M-9 Section Corner 24 & 25 T5S, R19W. Pulled State of Mich. Mon and Set 7" Long Iron Pipe w/BC Re-mon Brass Cap in Mon Box and is accepted as a careful and faithful perpetuation of the position of the original corner.
- M-10 1/4 Post Section 25, T5S R19W. Set B.C. Re-mon Brass cap in existing Iron Pipe in concrete in Mon Box and is accepted as a careful and faithful perpetuation of the original corner.
- M-9 Nail & Wit Tag S.E. Side Power Pole B315 28S 40° W 42.97'
S.E. Cor Bldg N60° W 86.15' Nail & Wit Tag N.E. Side Power Pole B297 48 N15°W 79.47'
7" Long Iron Pipe w/BC Re-mon Brass Cap in Mon Box with mortar T5S, R18W A-9 North 22.73'
- M-10 Nail & Wit Tag E. Side Power Pole B315 42 S 50° W 36.89'
Nail & Wit Tag N.W. Side 14" Maple N 50° E 52.77'
Chiseled "x" N.W. Cor Cone Headwall S30°E 38.10'
36" Long Iron Pipe w/Bc Re-mon Brass Cap in Mon Box T5S, R18W A-10 North 21.71'

Signed by Donald R. Pitts Jr Date 11/17/93
Surveyor's Michigan License No. 25867

FORM APPROVED BY MICHIGAN STATE BOARD OF LAND SURVEYORS, JAN. 28, 1971
REVISED MAY 14, 1975
REVISED JAN., 1983