

**SURVEY & REMONUMENTATION**

DEC 08 1993

COMMISSION

BERRIEN CO. REMONUMENTATION  
**LAND CORNER RECORDATION CERTIFICATE**  
 Filing Requirement of Act 74, Mich. P.A. 1970

11/29/93 RECORDED 111#2802 A33  
 CORNER \$7.00  
 11/29/93 111#2802 A33  
 STATE REMON FEE \$2.00

Nov 29 10 21 AM '93

*Berrien Trust Company*  
 REGISTER OF DEEDS  
 BERRIEN COUNTY, MICHIGAN

For corners in

Berrien

(County)

Located In:

Corner Code #

- |                                    |   |           |   |            |             |
|------------------------------------|---|-----------|---|------------|-------------|
| 1. Public Land Survey              | T | <u>5S</u> | R | <u>19W</u> | <u>M-11</u> |
|                                    | T | _____     | R | _____      | _____       |
|                                    | T | _____     | R | _____      | _____       |
|                                    | T | _____     | R | _____      | _____       |
| 2. Property Controlling in Section | S | _____     | T | _____      | _____       |
|                                    | S | _____     | T | _____      | _____       |
| 3. Miscellaneous Property in Sec.  | S | _____     | T | _____      | _____       |
|                                    | S | _____     | T | _____      | _____       |

Register of Deeds Stamp & File Number

4. Lot No. \_\_\_\_\_, Recorded Plat \_\_\_\_\_  
 5. Private Claims \_\_\_\_\_

	A	B	C	D	E	F	G	H	I	J	K	L	M
2	6	5	4	3	2	1							
3													
4	7	8	9	10	11	12							
5													
6	18	17	16	15	14	13							
7													
8	19	20	21	22	23	24							
9													
10	30	29	28	27	26	25							
11													
12	31	32	33	34	35	36							
13													

I, Donald R. Pitts, Jr., in a field survey on November 15, 1993, do hereby certify that under requirements of P.A. 74, Michigan P.A. of 1970, the corner points mentioned in lines 1 and 2 above were in conformance with regulations and rules, therefore as required in the current manual of survey instructions of the United States Department of the Interior, Bureau of Land Management or by a decree of a Court of Law and/or that the corner points mentioned in lines 3, 4 and 5 above were in conformance with the rules of the Michigan Board of Land Surveyors or by a Decree of a Court of Law; established, re-established, monumented, re-monumented, recovered, found as expressed below:

**NOTE: Not more than 4 corners, all in the same town and range, may be recorded on this certificate.**

A. Description of original monument and accessories and/or subsequent restoration:

- M-11 Section Corner 25 & 36 T5S, R19W  
 1829 August Deputy Surveyor Lucius Lyon Set Post. Aspen 9 N79W 3.31, Willow 6 N1½W 3.58  
 1948 - 1960 - Berrien Co. Road Commission - Plug  
 1974 - R.J. Beland - Mon Box, Recorded Liber 2, Page 93  
 1981 - J.G. Kamer - Plug in Mon Box  
 1990 - 1991 - R.L. Harner - Plug  
 1991 - D.R. Pitts, Jr. - Plug in Mon Box


B. Description of corner evidence found and/or method applied in restoring or reestablishing corner:

M-11 Section Corner 25 & 36 T5S, R19W  
 Found Plug in Mon Box. Found Railroad Spike T5S, R18W, A-11 North 21.10' and is accepted as a careful and faithful reestablishment of the position of the original corner, and ratified by the Berrien County Remonumentation Program Peer Group on November 8, 1993.

C. Description of monument for corner and accessories established to perpetuate locating the position of the corner:

- M-11 Section Corner 25 & 36 T5S, R19W  
 36" Long Iron Pipe with Berrien Co. Remon. Brass Cap in Mon Box.  
 Nail & Wit Tag in N.E. Side Power Pole B315-112 N35°W 50.25'  
 Nail & Wit Tag in S.E. Side Power Pole B333-89 S40°W 48.47'  
 Nail & Wit Tag in S.W. Side Power Pole B334-38 S40°E 48.84'  
 36" Long Iron Pipe with Berrien Co. Remon. in Mon Box, T5S, R18W A-11 North 21.10'

Signed by Donald R. Pitts, Jr.  
 Surveyor's Michigan License No. 25867

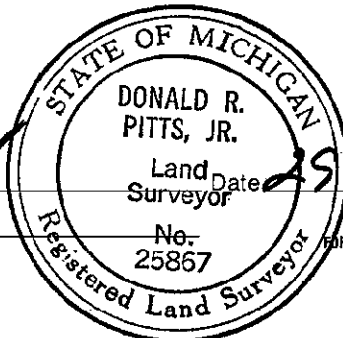

Date 29 November 1993