


# Meander corners

1994

Town 6 South Range 17 West

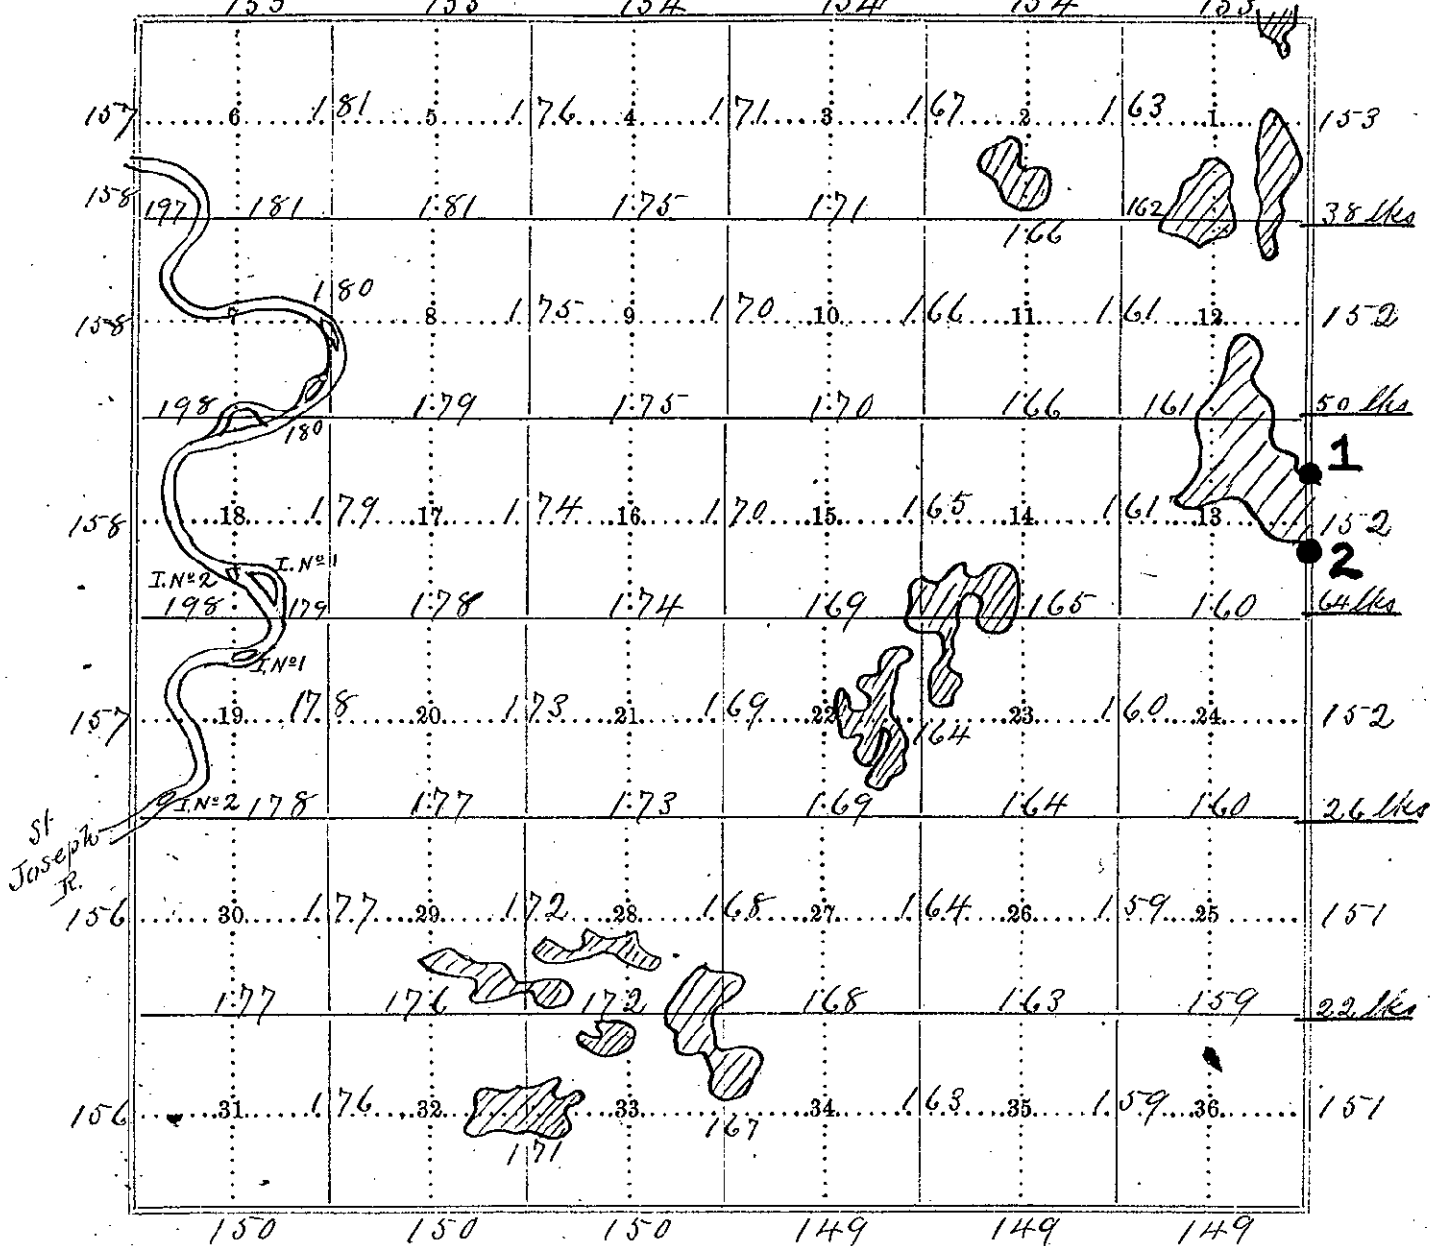

Meanders of Lakes + East side of River on Pages 182-1  
 Meanders of West side of R. on Pages 197-19  
 Survey of Islands on Pages 199 to 203

Berrien  
 Jurg

SURVEY &  
 REMONUMENTATION

NOV 2 1996

COMMISSION