SURVEY & REMONUMENTATION

RATIFIED BY THE BERRIEN COUNTY SURVEY PEER GROUP AS THE OFFICIAL CORNER UNDER MICHIGAN PUBLIC ACT 345 OF 1990

11-29-94

APR 2 6 1995

COMMISSION

RECORDED
RECORDED

BERRIEN COUNTY REMONUMENTATION PROGRAM

LAND CORNER RECORDATION CERTIFICATE

Filing Requirement of Act 74, Mich. P.A. 1970

DEC 2 11 11 AM '94
DEC 2 11 11 AM '94

REGISTER OF DEEDS
BERRIEN COUNTY MICHIGAN

For corners in Berrien (County)

	Located in:	Corner Code #
1. Public Land Survey	T6 S., R 17 W.	E-4
	T ___ R ___	
	T ___ R ___	
	T ___ R ___	
2. Property Controlling	S ___ T ___ R ___	
in Section	S ___ T ___ R ___	
3. Miscellaneous	S ___ T ___ R ___	
Property in Sec.	S ___ T ___ R ___	

12/02/94	111#8049	A99
	CORNER	$7.00
12/02/94	111#8049	A99
	STATE REMON FEE	$2.00

Register of Deeds Stamp & File Number

4. Lot No. _____ , Recorded Plat _____
5. Private Claims _____

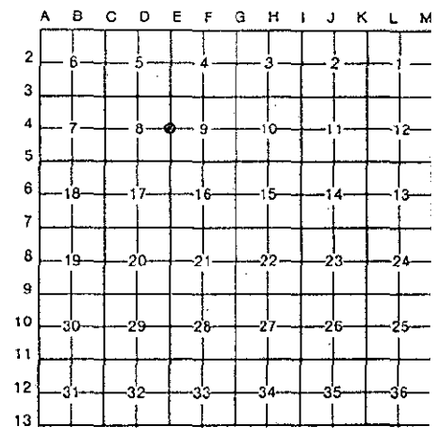

I, R.L. Harner, in a field survey on November 30, 19 94, do hereby certify that under requirements of P.A. 74, Michigan P.A. of 1970, the corner points mentioned in lines 1 and 2 above were in conformance with regulations and rules therefore as required in the current manual of survey instructions of the United States Department of the Interior, Bureau of Land Management or by a decree of a Court of Law and/or that the corner points mentioned in lines 3, 4 and 5 above were in conformance with the rules of the Michigan Board of Land Surveyors or by a Decree of a Court of Law; established, re-established, monumented, re-monumented, recovered, found as expressed below:

NOTE: Not more than 4 corners, all in the same town and range, may be recorded on this certificate.

A. Description of original monument and accessories and/or subsequent restoration:

E-4
Government - post
Beech 16" N. 56° W. 13 links
Lynn 4" S. 6 2/3° E. 19 links

E.R. Stefan September 5, 1974
stone
face twin tree West 4.75'
face twin tree S. 45° E. 31.7'
face 8" Beech N. 60° E. 26.65'

Berrien County Road Commission
stone on South side of corner fence post
at Southwest corner of woods.

B. *Description of corner evidence found and/or method applied in restoring or reestablishing corner:*

E-4
found stone

C. Description of monument for corner and accessories established to perpetuate locating the position of the corner:

E-4
removed stone and set concrete monument
nail and washer in 24" twin Oak N. 60° W. 4.62'
nail and washer in 18" Oak S. 30° E. 13.36'
nail and washer in 10" Oak N. 76° E. 24.65'
nail and washer in 20" Oak North 50.10'

*Accepted as a careful and faithful perpetuation of the position of the orginal corner.

Signed by _____ Date 30 Nov 1994

Surveyor's Michigan License No. 22436

FORM APPROVED BY MICHIGAN STATE BOARD OF LAND SURVEYORS, JAN. 28, 197
REVISED MAY 14, 197
REVISED JAN., 198