

RATIFIED BY THE BERRIEN COUNTY SURVEY PEER GROUP AS THE OFFICIAL CORNER UNDER MICHIGAN PUBLIC ACT 345 OF 1990

AND CORNER RECORDATION CERTIFICATE

FILING REQUIREMENT OF ACT 74, MICH. P.A. 1970

BERRIEN COUNTY REMONUMENTATION

Robert W. Prestine
7-06-94

APR 30 3 47 PM '94
REGISTER OF DEEDS
BERRIEN COUNTY MICHIGAN

RECORDED

FOR CORNERS OF	LOCATED IN--	CORNER CODE NUMBER
1. PUBLIC LAND SURVEY	T. 6 N. S., R. 17 E. W.	M-7
2. PROPERTY CONTROLLING IN SECTION 24	T. 6 N. S., R. 17 E. W.	08730/94
3. MISCELLANEOUS PROPERTY IN SECTION	T. N. S., R. E. W.	08730/94
4. LOT NO. _____, RECORDED PLAT _____		
5. PRIVATE CLAIMS _____		

111W2168 A99
CORNER \$7.00
111W2168 A99
STATE REMON FEE \$2.00

REGISTER OF DEEDS STAMP AND FILING NUMBER

I, Robert W. Prestine, do hereby certify that under requirements of P.A. 74, Michigan P.A. of 1970, the corner points mentioned in lines 1 and 2 above were, in a field survey on June, 1994, established, re-established, monumented, re-monumented, recovered or restored as expressed below and in conformance with regulations and rules therefore as required in the current manual of survey instructions of the United States Department of the Interior, Bureau of Land Management or by a decree of a court of law. Furthermore, that the corner points mentioned in lines 3, 4 and 5 above were, in a field survey on _____, 19____, found, recovered, restored, established or re-established as expressed below and in conformance with the rules of the Michigan State Board of Registration for Land Surveyors or, by a Decree of a Court of law:

A. Description of original monument and accessories and/or subsequent restoration:

M-7
NE cor. Sec. 24
Set post Wm. Brookfield D.S. March 1827
Govt. Elm 16" N 64 1/4° W 16 Lks.
Elm 12" S 10 1/4° W 45 Lks.

SURVEY & REMONUMENTATION

SEP 15 1994

COMMISSION

B. Description of corner evidence found and/or method applied in restoring or re-establishing corner:

M-7
1/2" Iron found 42.24 feet, 64 lks. South of NW Cor. Sec. 19-6-16

C. Description of monument for corner and accessories established to perpetuate locating the position of the corner:

M-7
Removed 1/2" iron & set 3/4" x 36" pipe with Berrien County Remonumentation Cap in Mon. box.
Center line 38" Maple N 4° W 63.8' Nail & washer in E. side.
Center line 26" W. Cherry S 3° W 23.0' Nail & washer in E. side.
Center line 29" Maple N 73° W 80.8' Nail & washer in S. side.
Center line Road as traveled North 9.2'


SIGNED BY Robert W. Prestine DATE August 27, 1994

SURVEYOR'S MICHIGAN REGISTRATION NO. 18662

FOR STATE AND UNITED STATES AGENCIES:

SIGNED BY _____ DATE _____
CHIEF OF SURVEY PARTY

APPROVED AND SIGNED BY _____ DATE _____
MICHIGAN REGISTERED LAND SURVEYOR

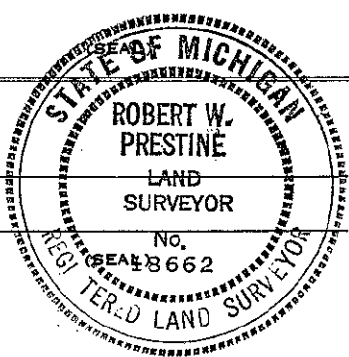

LIBER 3 PAGE 119

SURVEYOR'S MICHIGAN REGISTRATION NO. _____