

RATIFIED BY THE BERRIEN COUNTY SURVEY PEER GROUP AS THE OFFICIAL CORNER UNDER MICHIGAN PUBLIC ACT 348 OF 1990

LAND CORNER RECORDATION CERTIFICATE

FILING REQUIREMENT OF ACT 74, MICH. P.A. 1970

BERRIEN COUNTY REMONUMENTATION

Robert W. Prestine
7-06-94

FOR CORNERS OF--	Berrien County	LOCATED IN--	CORNER CODE NUMBER
1. PUBLIC LAND SURVEY	T. 6 N. S., R. 17 E.		M-13 (7-17-M)
2. PROPERTY CONTROLLING IN SECTION 36	T. 6 N. S., R. 17 E.		
3. MISCELLANEOUS PROPERTY IN SECTION	T. N. S., R. E.		
4. LOT NO. _____, RECORDED PLAT _____			
5. PRIVATE CLAIMS _____			

RECORDED

AUG 30 3 45 PM '94

Robert W. Prestine
08/30/94 REGISTER OF DEEDS 111#2168 A99
BERRIEN COUNTY REGISTER OF DEEDS 111#2168 A99
REGISTER OF DEEDS STAMP AND FILING NUMBER \$2.00

I, Robert W. Prestine, do hereby certify that under requirements of P.A. 74, Michigan P.A. of 1970, the corner points mentioned in lines 1 and 2 above were, in a field survey on June, 1994, established, re-established, monumented, re-monumented, recovered or restored as expressed below and in conformance with regulations and rules therefore as required in the current manual of survey instructions of the United States Department of the Interior, Bureau of Land Management or by a decree of a court of law. Furthermore, that the corner points mentioned in lines 3, 4 and 5 above were, in a field survey on _____, 19____, found, recovered, restored, established or re-established as expressed below and in conformance with the rules of the Michigan State Board of Registration for Land Surveyors or, by a Decree of a Court of law:

A. Description of original monument and accessories and/or subsequent restoration:

M-13
SE. cor. Sec. 36
Set post Wm. Brookfield March 1827
W. Oak 18" S 38½° W 19 lks.
W. Oak 8" N 46° E 31 lks.

SURVEY & REMONUMENTATION
SEP 15 1994
COMMISSION

B. Description of corner evidence found and/or method applied in restoring or re-establishing corner:

M-13
Found large stone with large cross
Originally found August, 1973
In open field with 4" cedar post as guard
Corner common to 4 Sec's. & 4 Twp's.

C. Description of monument for corner and accessories established to perpetuate locating the position of the corner:

M-13
Left stone, could not remove, estimated weight 300 lbs.++
Set Berrien County remonumentation cap in top of stone

Centerline of I. & M. Tower S 25° 55' W 595.50'
3/4" iron in centerline of Creek Road East 191.70'
No other wit's. near.


SIGNED BY *Robert W. Prestine* DATE August 27, 1994

SURVEYOR'S MICHIGAN REGISTRATION NO. 18662

FOR STATE AND UNITED STATES AGENCIES:

SIGNED BY _____ DATE _____
CHIEF OF SURVEY PARTY

APPROVED AND SIGNED BY _____ DATE _____
MICHIGAN REGISTERED LAND SURVEYOR

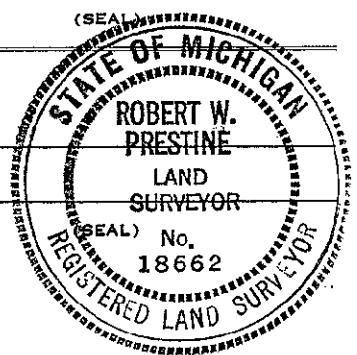

LIBER 3 PAGE 113

SURVEYOR'S MICHIGAN REGISTRATION NO. _____