

RAISED BY THE BERRIEN COUNTY SURVEY PEER GROUP AS THE OFFICIAL CORNER UNDER MICHIGAN PUBLIC ACT 345 OF 1990.

Berrien County Remonumentation
LAND CORNER RECORDATION CERTIFICATE
 Filing Requirement of Act 74, Mich. P.A. 1970

Charles W. Barger
 November 29, 1994

For corners in	Berrien	Located in:	Corner Code #
	(County)		
1. Public Land Survey	T 7 R 18	A-1	
Comments: T6S, R18W, A13	T R		
T6S, R19W, M13	T R		
T7S, R19W, M1	T R	A-13	
2. Property Controlling	S T R		
in Section	S T R		
3. Miscellaneous	S T R		
Property in Sec.	S T R		

RECORDED
 DEC 16 4 02 PM '94
 REGISTER OF DEEDS
 BERRIEN COUNTY MICHIGAN
 Register of Deeds Stamp & File Number

4. Lot No. _____, Recorded Plat _____
 5. Private Claims _____

A	B	C	D	E	F	G	H	I	J	K	L	M
2	6	5	4	3	2	1						
3												
4	7	8	9	10	11	12						
5												
6	18	17	16	15	14	13						
7												
8	19	20	21	22	23	24						
9												
10	30	29	28	27	26	25						
11												
12	31	32	33	34	35	36						
13												

I, Charles W. Barger, in a field survey on November, 19 94, do hereby certify that under requirements of P.A. 74, Michigan P.A. of 1970, the corner points mentioned in lines 1 and 2 above were in conformance with regulations and rules therefore as required in the current manual of survey instructions of the United States Department of the Interior, Bureau of Land Management or by a decree of a Court of Law and/or that the corner points mentioned in lines 3, 4 and 5 above were in conformance with the rules of the Michigan Board of Land Surveyors or by a Decree of a Court of Law; established, re-established, monumented, re-monumented, recovered, found as expressed below:

NOTE: Not more than 4 corners, all in the same town and range, may be recorded on this certificate.

A. Description of original monument and accessories and/or subsequent restoration:


July 1828 - William Brookfield Set frost corner to Townships 6 & 7 South, Ranges 18 & 19 West.

Lynn 20 S. 75 E. 37	12/16/94	111#7004	A66
Sugar 20 N. 10 1/2 E. 60	12/16/94	111#9004	A66
		STATE REMON FEE	\$2.00

B. Description of corner evidence found and/or method applied in restoring or reestablishing corner:

A-1 Found 3/4" Iron rod
 Found 3/4" Iron Pipe West 33.0 (1.3' deep)

SURVEY &
 COMMISSION
 DEC 07 1995
 COMMISSION

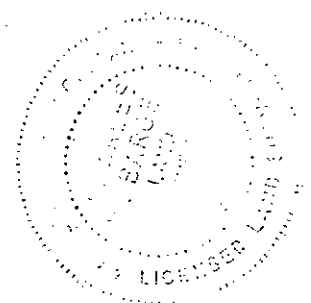

C. Description of monument for corner and accessories established to perpetuate locating the position of the corner:

A-1 Set 1" pipe 2' long in Monument Box w/Brass Remonumentation Cap (2 1/2")
 Set Nail & Witness Tag in Base of Cherry Tree S.89°W., 62.4'
 Set Nail & Witness Tag in PP by Telephone Riser S.57E., 52.5'
 Set Nail & Witness Tag in Telephone Buried Cable Post (4x4)
 N.21E., 70.0'
 Found 3/4" Iron Pipe West 33.0 (1.3' deep)

And is accepted as a careful and faithful perpetuation of the position of the original corner.

Signed by Charles W. Barger P.S. Date December 16, 1994
 Surveyor's Michigan License No. 31589

EAST CORNER - SECTION 36-6-19
NORTH EAST CORNER - SECTION 1-7-1
SOUTH WEST CORNER - SECTION 31-6-18
NORTHWEST CORNER - SECTION 6-7-18 (A-1)

JULY. 1828 William Brookfield L2. P3 Government Notes
80.00 Set frost corner to Townships 6 & 7 South. Ranges 18
& 19 West
Lvnn 20 S. 75 E. 37
Sugar 20 N. 10 1/2 E. 60

1829 Lucius Lyon L2. P62 Government Notes
80.00 Set frost corner to Townships 6 & 7 South. Ranges 18
& 19 West
Lvnn 20 S. 75 E. 37
Sugar 20 N. 10 1/2 E. 60

Circa 1945 Berrien County Road Commission
R.R. Spike
Cor. Grape Post SE 35.4'
Iron Pipe & Fence West 33' on line
Cor. Cherry SE 46.3'
Cherry Row East is South 34.0'
Cherry Row South is East 31.5'
Cor. Headwall SE 24.4'
Cor. Headwall NE 29.6'

Feb. 1951 H.L. Dreher
R.R. Spike

JAN. 1983 J. Kamer L. 1181. P. 1260 Recorded Survey
Found 3/4" Iron
PK in Cor. Fence Post S. 88 W. 24.32'
PK in Tele. Buried Cable Post S. 40 E. 64.35'
PK in Guard Post N. 20 W. 65.79'

NOV. 1994 C.W. Barber
Found 3/4" Iron Rod
Set Nail & Witness Tag in base of Cherry Tree S. 89 W 62.4'
Set Nail & Witness Tag in PP by Tele. Riser S. 57 E. 52.5
Set Nail & Witness Tag in Tele. Buried Cable Post (4x4)
N. 21 E. 70.0'
Found 3/4" Iron Pipe West 33.0 (1.3' deep)

SURVEY &
7-11-1995

DEC 17 1995

COPIED