

APPROVED BY THE BERRIEN COUNTY SURVEY PEER GROUP AS THE OFFICIAL CORNER UNDER MICHIGAN PUBLIC ACT 345 OF 1990

RECORDED

BERRIEN COUNTY REMONUMENTATION
LAND CORNER RECORDATION CERTIFICATE
 Filing Requirement of Act 74, Mich. P.A. 1970

DEC 26 11 46 AM '96

Charles W. Barger
 10-24-96

Berrien Township
 REGISTER OF DEEDS
 BERRIEN COUNTY MICHIGAN

For corners in	Located In:	Corner Code #
BERRIEN (County)		
1. Public Land Survey	T 6S R 18W	E13
	T R	
	T R	
	T R	
2. Property Controlling in Section	S T R	
	S T R	
3. Miscellaneous Property in Sec.	S T R	
	S T R	
4. Lot No. _____, Recorded Plat _____		
5. Private Claims _____		

12/26/96 111#9871 A99
 CORNER \$9.00
 12/26/96 111#9871 A99
 STATE REMON FEE \$2.00
Register of Deeds Stamp & File Number

I, CHARLES W. BARGER, in a field survey on DECEMBER, 19 96, do hereby certify that under requirements of P.A. 74, Michigan P.A. of 1970, the corner points mentioned in lines 1 and 2 above were in conformance with regulations and rules therefore as required in the current manual of survey instructions of the United States Department of the Interior, Bureau of Land Management or by a decree of a Court of Law and/or that the corner points mentioned in lines 3, 4 and 5 above were in conformance with the rules of the Michigan Board of Land Surveyors or by a Decree of a Court of Law; established, re-established, monumented, re-monumented, recovered, found as expressed below:

	A	B	C	D	E	F	G	H	I	J	K	L	M
2	6		5		4		3		2		1		
3													
4	7		8		9		10		11		12		
5													
6	18		17		16		15		14		13		
7													
8	19		20		21		22		23		24		
9													
10	30		29		28		27		26		25		
11													
12	31		32		33		34		35		36		
13													

NOTE: Not more than 4 corners, all in the same town and range, may be recorded on this certificate.

A. Description of original monument and accessories and/or subsequent restoration:
 MARCH 1827 SET POST COMMON TO SECTIONS 32 & 33
 W. BROOKFIELD LYNN 10 N69W 12
 ASH 9 N83E 21

B. Description of corner evidence found and/or method applied in restoring or reestablishing corner:
 JULY 1996 FOUND 3/4" IRON PIPE
 C. BARGER RR RAIL IN CONCRETE W 22.9'
 WITNESS NAIL IN 12" TREE N10°W 19.3'
 WITNESS NAIL IN 18" TREE S 17.8'
 IRON BAR EAST 69.82'


SURVEY &
 REMONUMENTATION

MAY 20 1997

COMMISSION

C. Description of monument for corner and accessories established to perpetuate locating the position of the corner:
 E13 1"PIPE 36"LONG WITH 2 1/2" REMONUMENTATION BRASS CAP IN MONUMENT BOX
 RR RAIL IN CONCRETE W 22.9'
 WITNESS NAIL IN 12" TREE N10°W 19.3'
 WITNESS NAIL IN 18" TREE S 17.8'
 REMONUMENTATION MARKER EAST 69.82'

AND IS ACCEPTED AS A CAREFUL AND FAITHFUL PERPETUATION OF THE POSITION OF THE ORIGINAL CORNER.

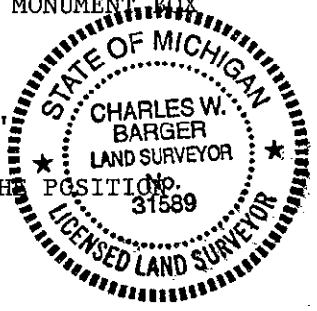

Signed by Charles W. Barger
 Surveyor's Michigan License No. 31589

Date DECEMBER 19, 1996

BARGER ENGINEERING, INC.
BERRIEN COUNTY REMONUMENTATION

SOUTHWEST CORNER SECTION 33, TOWNSHIP 6 SOUTH, RANGE 18 WEST

E13
BURGOYNE ROAD

MARCH 1827 W. BROOKFIELD	SET POST COMMON TO SECTIONS 32 & 33 LYNN 10 N69 W 12 ASH 9 N83 E 21
JANUARY 1960 D. DREHER	SURVEY SW CORNER SECTION 33, T6S, R18W CORNER SHOWN, NOT RECORDED
JULY 1996 C. BARGER	FOUND 3/4" IRON PIPE RR RAIL IN CONCRETE W 22.9' WITNESS NAIL IN 12" TREE N10°W 19.3' WITNESS NAIL IN 18" TREE S 17.8' IRON BAR EAST 69.82'
OCTOBER 1974 ER STEPHEN	RECORDED CORNER E-1 (7-18) FOUND IRON PIPE IRON PIPE WEST 69.82' NAIL IN 18" SYCAMORE S40°W 74.38' NAIL IN 14" TREE EAST 14.55'
FEBRUARY 1995 R. PRESTINE	SURVEY SW CORNER SECTION 33, T6S, R18W CORNER SHOWN, NOT RECORDED

SURVEY &
REMONUMENTATION

MAY 20 1997

COMMISSION