

RATIFIED BY THE BERRIEN COUNTY SURVEY PEER GROUP AS THE OFFICIAL CORNER UNDER MICHIGAN PUBLIC ACT 345 OF 1990

RECORDED

BERRIEN COUNTY REMONUMENTATION LAND CORNER RECORDATION CERTIFICATE Filing Requirement of Act 74, Mich. P.A. 1970

97 OCT 31 PM 2:04

BERNICE TRETHERWAY REGISTER OF DEEDS BERRIEN COUNTY, MICHIGAN

Charles W. Barger
10-23-97
For corners in

BERRIEN (County)	Located In:	Corner Code #
1. Public Land Survey	T <u>6</u> R <u>19</u>	<u>F-13</u>
	T ___ R ___	_____
	T ___ R ___	_____
	T ___ R ___	_____
2. Property Controlling in Section	S ___ T ___ R ___	_____
	S ___ T ___ R ___	_____
3. Miscellaneous Property in Sec.	S ___ T ___ R ___	_____
	S ___ T ___ R ___	_____

10/31/97 111#2484 A99
CORNER \$9.00
10/31/97 111#2484 A99
STATE REMON FEE \$2.00
Register of Deeds Stamp & File Number

- 4. Lot No. _____, Recorded Plat _____
- 5. Private Claims _____

I, CHARLES W. BARGER, in a field survey on OCTOBER, 1997, do hereby certify that under requirements of P.A. 74, Michigan P.A. of 1970, the corner points mentioned in lines 1 and 2 above were in conformance with regulations and rules therefore as required in the current manual of survey instructions of the United States Department of the Interior, Bureau of Land Management or by a decree of a Court of Law and/or that the corner points mentioned in lines 3, 4 and 5 above were in conformance with the rules of the Michigan Board of Land Surveyors or by a Decree of a Court of Law; established, re-established, monumented, re-monumented, recovered, found as expressed below:

	A	B	C	D	E	F	G	H	I	J	K	L	M
2	6		5		4		3		2		1		
3													
4	7		8		9		10		11		12		
5													
6	13		17		16		15		14		13		
7													
8	19		20		21		22		23		24		
9													
10	30		29		28		27		26		25		
11													
12	31		32		33		34		35		36		
13													

NOTE: Not more than 4 corners, all in the same town and range, may be recorded on this certificate.

A. Description of original monument and accessories and/or subsequent restoration:

L. LYON 1830 LYNN 34 N55W 24 BURCH 11 N40E 43

Surveyor's REMONUMENTATION

NOV 21 1997

COMMISSION


B. Description of corner evidence found and/or method applied in restoring or reestablishing corner:

C. BARGER 1997 FOUND 5/8" REBAR IN MONUMENT BOX
SAN MH N70DEG49'W 14.12'
HYDRANT N29DEGE 64.07'
WATER MANHOLE N29DEG06'E 51.96'
5/8" REBAR IN MON E 40.88'

C. Description of monument for corner and accessories established to perpetuate locating the position of the corner:

F-13 SET 1" PIPE 36" LONG WITH 2 1/2" REMONUMENTATION BRASS CAP IN MONUMENT BOX
SAN MANHOLE N70DEG49'W 14.12'
HYDRANT N29DEGE 64.07'
WATER MANHOLE N29DEG06'E 51.96'
2 1/2" REMONUMENT MARKER OVER 1" PIPE E 40.88'

AND IS ACCEPTED AS A CAREFUL AND FAITHFUL PERPETUATION OF THE POSITION OF THE ORIGINAL CORNER.

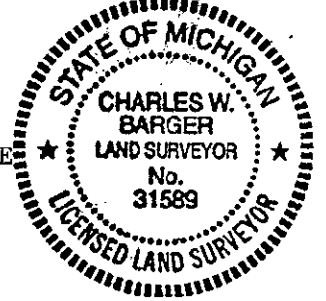

Signed by Charles W. Barger Date OCTOBER 31, 1997
Surveyor's Michigan License No. 31589

BARGER ENGINEERING, INC.
BERRIEN COUNTY REMONUMENTATION

SOUTH QUARTER POST SECTION 33, TOWNSHIP 6 SOUTH, RANGE 19 WEST
(F-13)

BROWNTOWN & DATE

L. Lyon
1830

Lynn 34 N55W 24
Burch 11 N40e 43

Berrien County
Road Commission
1920-45

Plow Point

C. Barger
1997

5/8" Rebar in Monument Box
San MH N70deg49'W 14.12'
Hydrant N29degE 64.07'
Water MH N29deg06'E 51.96'
5/8" Rebar in Mon E 40.88'

BARGER ENGINEERING, INC.
REMONUMENTATION

NOV 21 1997

COMMISSION

Job Assignment 1997-02-0293

LIBER

4 PAGE

6