

RATIFIED BY THE BERRIEN COUNTY SURVEY PEER GROUP AS THE OFFICIAL CORNER UNDER MICHIGAN PUBLIC ACT 345 OF 1990

RECORDED

BERRIEN COUNTY REMONUMENTATION LAND CORNER RECORDATION CERTIFICATE

97 OCT 31 PM 2:04

BERRICE TRETHERWAY REGISTER OF DEEDS BERRIEN COUNTY, MICHIGAN

BERRIEN (County)

Located In:

Corner Code #

- 1. Public Land Survey T 6 R 19 G-5
- 2. Property Controlling in Section S T R
- 3. Miscellaneous Property in Sec. S T R
- 4. Lot No. , Recorded Plat
- 5. Private Claims

10/31/97 111#2484 A99
 Register of Deeds Stamp & File Number \$9.00
 10/31/97 111#2484 A99
 STATE REMON FEE \$2.00

	A	B	C	D	E	F	G	H	I	J	K	L	M
2	6	5	4	3	2	1							
3													
4	7	8	9	10	11	12							
5													
6	18	17	16	15	14	13							
7													
8	19	20	21	22	23	24							
9													
10	30	29	28	27	26	25							
11													
12	31	32	33	34	35	36							
13													

I, CHARLES W. BARGER, in a field survey on OCTOBER, 19 97, do hereby certify that under requirements of P.A. 74, Michigan P.A. of 1970, the corner points mentioned in lines 1 and 2 above were in conformance with regulations and rules therefore as required in the current manual of survey instructions of the United States Department of the Interior, Bureau of Land Management or by a decree of a Court of Law and/or that the corner points mentioned in lines 3, 4 and 5 above were in conformance with the rules of the Michigan Board of Land Surveyors or by a Decree of a Court of Law; established, re-established, monumented, re-monumented, recovered, found as expressed below:

NOTE: Not more than 4 corners, all in the same town and range, may be recorded on this certificate.

A. Description of original monument and accessories and/or subsequent restoration:

L. LYON SET POST COR TO SEC 9-10-15 & 16
 JULY 1830 BEECH 5 S78E 17
 BEECH 10 N35W 39

SURVEY & REMONUMENTATION

NOV 21 1997

COMMISSION


B. Description of corner evidence found and/or method applied in restoring or reestablishing corner:

C. BARGER 1" BAR IN MON BOX
 AUG 1997 FOUND P.K. IN PST S44DEG53'E 49.3'
 FOUND P.K. IN 9" PEAR S17DEG23'E 71.55'
 FOUND P.K. IN PST S46DEG58'W 47.96'
 FOUND P.K. IN PP N45DEG25'W 42.46'

C. Description of monument for corner and accessories established to perpetuate locating the position of the corner:

G-5 1" PIPE 36" LONG WITH 2 1/2" REMONUMENTATION BRASS CAP IN MONUMENT BOX
 WITNESS TAG IN PST S44DEG53'E 49.3'
 WITNESS TAG IN 9" PEAR S17DEG23'E 71.55'
 WITNESS TAG IN PST S46DEG58'W 47.96'
 WITNESS TAG IN PP N45DEG25'W 42.46'

AND IS ACCEPTED AS A CAREFUL AND FAITHFUL PERPETUATION OF THE POSITION OF THE ORIGINAL CORNER.

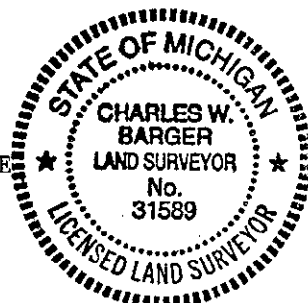

Signed by Charles W. Barger
 Surveyor's Michigan License No. 31589

Date OCTOBER 31, 1997

BARGER ENGINEERING, INC.
 BERRIEN COUNTY REMONUMENTATION

SOUTHWEST CORNER SECTION 10, TOWNSHIP 6 SOUTH, RANGE 19 WEST
 (G-5)

HOLDEN ROAD & LEMON CREEK ROAD

L. Lyon July 1830	Set Post Cor to Sec 9-10-15 &16 Beech 5 S78E 17 Beech 10 N35W 39		
Berrien County Road Commission 1940-1959	Cap El. Pole T.P. Cor Appel	NW SW SE	45.6' 74.8' 42.8'
Robert Beland Nov 1974	Plug Found PP SW Cor Hdwl NW Cor Hdwl NE Cor Hdwl	N42degW NE SE S48degW	41.8' 27.9' 29.4' 29.9'
J. Kamer 1981	Rebar P.K. in Pst Nail in Pst P.K. in PP	S44degE S47degW N45degW	49.29' 48.0' 42.24'
J. Kamer 1983	1/2" Rebar in Mon Box P.K. in PP P.K. in Pst P.K. in Pst	N45degW S45degW S45degE	42.2' 47.95' 49.25'
J. Kamer 1997	1/2" Iron in Mon Box P.K. in PP P.K. in Pst P.K. in Pst P.K. in 12" Elm	N45degW S45degW S45degE S10degE	42.29' 47.85' 49.25' 71.32'
C. Barger Aug 1997	1" Bar in Mon Box Found P.K. in Pst Found P.K. in 9" Pear Tree Found P.K. in Pst Found P.K. in PP	S44deg53'E S17deg23'E S46deg58'W N45deg25'W	49.3' 71.55' 47.96' 42.46'

JOB ASSIGNMENT 1997-02-0295

SURVEY &
 REMONUMENTATION

NOV 21 1997

COMMISSION