

RAISED BY THE BERRIEN COUNTY SURVEY PEER GROUP AS THE OFFICIAL CORNER UNDER MICHIGAN PUBLIC ACT 348 OF 1988

09/02/94

111#2445 A33

CORNER \$9.00

09/02/94

111#2445 A33

STATE REMAIN FEE \$2.00

*John G. Kamer*  
8-18-94

**BERRIEN COUNTY REMONUMENTATION  
LAND CORNER RECORDATION CERTIFICATE**  
Filing Requirement of Act 74, Mich. P.A. 1970

For corners in

Berrien (County)	Located In:	Corner Code #
1. Public Land Survey	T <u>6S</u> R <u>19W</u>	<u>H-11</u>
	T _____ R _____	_____
	T _____ R _____	_____
	T _____ R _____	_____
2. Property Controlling in Section	S _____ T _____ R _____	_____
	S _____ T _____ R _____	_____
3. Miscellaneous Property in Sec.	S _____ T _____ R _____	_____
	S _____ T _____ R _____	_____

Berrien County  
 REGISTER OF DEEDS  
 RECORDATION PROGRAM

SEP 2 4 21 PM '94

RECORDED

Register of Deeds Stamp & File Number

4. Lot No. \_\_\_\_\_, Recorded Plat \_\_\_\_\_  
 5. Private Claims \_\_\_\_\_

	A	B	C	D	E	F	G	H	I	J	K	L	M
2	6		5		4		3		2		1		
3													
4	7		8		9		10		11		12		
5													
6	16		17		16		15		14		13		
7													
8	19		20		21		22		23		24		
9													
10	30		29		28		27		26		25		
11								●					
12	31		32		33		34		35		36		

I, John G. Kamer, in a field survey on August 26, 19 94, do hereby certify that under requirements of P.A. 74, Michigan P.A. of 1970, the corner points mentioned in lines 1 and 2 above were in conformance with regulations and rules therefore as required in the current manual of survey instructions of the United States Department of the Interior, Bureau of Land Management or by a decree of a Court of Law and/or that the corner points mentioned in lines 3, 4 and 5 above were in conformance with the rules of the Michigan Board of Land Surveyors or by a Decree of a Court of Law; established, re-established, monumented, re-monumented, recovered, found as expressed below:

**NOTE: Not more than 4 corners, all in the same town and range, may be recorded on this certificate.**

A. Description of original monument and accessories and/or subsequent restoration:

(See Back)

B. Description of corner evidence found and/or method applied in restoring or reestablishing corner:

Reestablished corner from 1992 witness ties. The perpetuation of the corner as evidenced by the history of witness ties appears reliable and accurate.

SURVEY &  
REMONUMENTATION


NOV 07 1994

COMMISSION

C. Description of monument for corner and accessories established to perpetuate locating the position of the corner:

H-11  
 Set conc mon. w/brass cap  
 Corner was not there. Used witness ties to reset (from 1992 Kamer)  
 NW corner headwall N25°E 4.20  
 SW corner headwall S41°E 1.80  
 SW corner headwall west side road S85°W 28.93'  
 Set 8 penny nail w/tag in wood fence post S75°W 69.43'

Signed by \_\_\_\_\_  
 Surveyor's Michigan License No. 27449

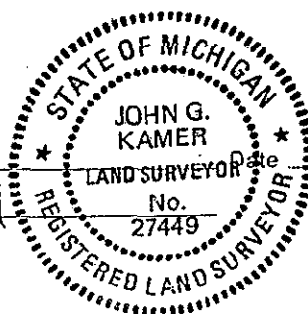

9-01-94

1830

Lucius Lyon  
Set 1/4 Post Com to Secs 27-6-19  
& 34-6-19  
39.91 Ch. E of SW Cor. 27-6-19 (Split of Mi.)  
Beech 20 S 48 W 7  
Beech 8 N 3 1/2 E 32

1945

J.H. Dewey  
(Fnd. Stone)

Fnd IP  
Hdwl. 2.0 East  
Centerline Rd. 11.5 West  
2-30" Trees - SE 62.5 ft.

July 27, 1972

Richard Garrett - W & A  
(Fnd Iron)  
Set Cen Sec. 34-6-19 2645.1

Aug. 8, 1975

Maurice R. Rushlow - W & A  
(Fnd. North 1/4 Corner I.P. 34-6-19)  
Centerline Rd. 11.50' West  
Headwall 2.0' East

March 15, 1976

Robert J. Beland  
1" Iron S. 1/4 Post Sec. 27  
N.W. Cor. Hdw. N.E. 4.2'  
S.W. Cor. Hdw. S.E. 1.7'  
L. Road W. 12.5'  
Elec. Pole S 40° W 117.8'

May 6, 1982

John G. Kamer (W & A)  
Witness:  
South 1/4 Corner  
Pinched Iron  
PK in Twin Elm N 85° E 15.43'  
NW Cor. of Headwall NE 4.2'  
SW Cor. of Headwall SE 1.7'  
Centerline of Road West 12.5'

July 29, 1986

John G. Kamer (W & A)  
Witness: 34-6-19  
N 1/4 Cor. IP  
Centerline Rd.  
11.5' West  
Headwall 2.0' East  
Dist. to Center Sec. 34-6-19 2644.86

12-11-89

John G. Kamer (W & A)  
(Found IP, 1" out of Grd.)  
Set PK in 12" Tree Stump N 80° E 15.55  
Conc. Hdw. East 1.8'  
Centerline Rd. West 12.4'

7-8-92

John G. Kamer (W & A)  
S. 1/4 27-6-19  
(Fnd. 1" Iron Pipe)  
NW. Cor. Headwall NE 4.2'  
SW. Cor. Headwall SE 1.8'  
Centerline Road West 12.5'  
SW. Cor. Headwall S 85° W 29.02'