

RATIFIED BY THE BERRIEN COUNTY SURVEY PEER GROUP AS THE OFFICIAL CORNER UNDER MICHIGAN PUBLIC ACT 345 OF 1990  
 10-23-97  
 For corners in

RECORDED

BERRIEN COUNTY REMONUMENTATION  
 LAND CORNER RECORDATION CERTIFICATE  
 Filing Requirement of Act 74, Mich. P.A. 1970

97 OCT 31 PM 2:04

BERNICE TRETHERWAY  
 REGISTER OF DEEDS  
 BERRIEN COUNTY, MICHIGAN

BERRIEN (County) Located In: Corner Code #  
 1. Public Land Survey T 6 R 19 H-13  
 Common to: T75, R19W, H-1  
 2. Property Controlling S T R  
 in Section S T R  
 3. Miscellaneous S T R  
 Property in Sec. S T R  
 4. Lot No. \_\_\_\_\_, Recorded Plat \_\_\_\_\_  
 5. Private Claims \_\_\_\_\_

10/31/97 111#2484 A99  
 CORNER \$9.00  
 10/31/97 111#2484 A99  
 Register of Deeds Stamp & File Number  
 STATE REMLN FEE \$2.00

I, CHARLES W. BARGER, in a field survey on OCTOBER, 19 97, do hereby certify that under requirements of P.A. 74, Michigan P.A. of 1970, the corner points mentioned in lines 1 and 2 above were in conformance with regulations and rules therefore as required in the current manual of survey instructions of the United States Department of the Interior, Bureau of Land Management or by a decree of a Court of Law and/or that the corner points mentioned in lines 3, 4 and 5 above were in conformance with the rules of the Michigan Board of Land Surveyors or by a Decree of a Court of Law; established, re-established, monumented, re-monumented, recovered, found as expressed below:

A	B	C	D	E	F	G	H	I	J	K	L	M
2	6	5	4	3	2	1						
3												
4	7	8	9	10	11	12						
5												
6	18	17	16	15	14	13						
7												
8	19	20	21	22	23	24						
9												
10	30	29	28	27	26	25						
11												
12	31	32	33	34	35	36						
13												

NOTE: Not more than 4 corners, all in the same town and range, may be recorded on this certificate.

A. Description of original monument and accessories and/or subsequent restoration:  
 L. LYON SET POST  
 1830 MAPLE 12 N68W 39  
 ALDER 4 N14E 13


SURVEY &  
 REMONUMENTATION  
 NOV 21 1997  
 COMMISSION

B. Description of corner evidence found and/or method applied in restoring or reestablishing corner:  
 C. BARGER FOUND 1" BAR  
 AUG 1997 P.K. IN W SIDE 48" POPULAR S10DEGW 34.41'  
 P.K. IN PP N40DEG54'E 44.0'  
 P.K. IN PP N30DEG30'W 41.95'  
 P.K. IN PP S8DEG25'E 28.65'

SURVEY &  
 REMONUMENTATION  
 MAR 06 1998  
 SECTION

C. Description of monument for corner and accessories established to perpetuate locating the position of the corner:  
 H-13 1" PIPE 36" LONG WITH 2 1/2" REMONUMENTATION BRASS CAP IN MONUMENT BOX  
 WITNESS TAG IN W SIDE 48" POPULAR S10DEGW 34.41'  
 WITNESS TAG IN PP N40DEG54'E 44.0'  
 WITNESS TAG IN PP N30DEG30'W 41.95'  
 WITNESS TAG IN PP S8DEG25'E 28.65'

AND IS ACCEPTED AS A CAREFUL AND FAITHFUL PERPETUATION OF THE POSITION OF THE ORIGINAL CORNER.

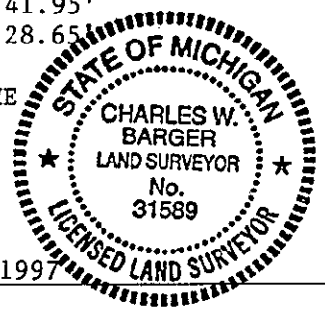

Signed by Charles W. Barger Date OCTOBER 31, 1997  
 Surveyor's Michigan License No. 31589

BARGER ENGINEERING, INC.  
BERRIEN COUNTY REMONUMENTATION

NORTH QUARTER CORNER SECTION 3, TOWNSHIP 7 SOUTH, RANGE 19 WEST  
(H-13)

LONDON ROAD & BROWNTOWN ROAD

L. Lyon  
1830

Set Post  
Maple 12 N68w 39  
Alder 4 N14E 13

Berrien County  
Road Commission  
1940-1959

No Record

Strebs  
?

Survey A4461  
Shows Existing Corner

R. Garrett  
July 1972

Iron Pipe  
PP N40degW 41.7'  
Guy Pole N45degE 43.5'  
24" Elm S 33.7'

C. Barger  
Aug 1997

1" Bar  
P.K. in W. Side 48" Popular S10degW 34.41'  
P.K. in PP N40deg54'E 44.0'  
P.K. in PP N30deg30'W 41.95'  
P.K. in PP S8deg25'E 28.65'

Survey &  
REMONUMENTATION

NOV 21 1997

COMMISSION

SURVEY &  
REMONUMENTATION

JOB ASSIGNMENT 1997-02-0300

MAR 06 1998

SECTION

LIBER

4 PAGE 18