

RATIFIED BY THE BERRIEN COUNTY SURVEY PEER GROUP AS THE OFFICIAL CORNER UNDER MICHIGAN PUBLIC ACT 348 OF 1990

[Signature]
10-23-97

For corners in BERRIEN (County)

RE RECORDED TO CORRECT TOWNSHIP BERRIEN COUNTY REMONUMENTATION
LAND CORNER RECORDATION CERTIFICATE
Filing Requirement of Act 74, Mich. P.A. 1970

RECORDED

97 OCT 31 PM 2:04

BERNICE TRETHERWAY
REGISTER OF DEEDS
BERRIEN COUNTY, MICHIGAN

Located In: _____ Corner Code H-13

1. Public Land Survey T 6 R 19
Common to: T75, R19W, H-1
T _____ R _____
T _____ R _____
T _____ R _____
T _____ R _____

2. Property Controlling S _____ T _____ R _____
in Section S _____ T _____ R _____

3. Miscellaneous S _____ T _____ R _____
Property in Sec. S _____ T _____ R _____

4. Lot No. _____, Recorded Plat _____

5. Private Claims _____

10/31/97
10/31/97
Register of Deeds Stamp & File Number

I, CHARLES W. BARGER, in a field survey on OCTOBER, 19 97, do hereby certify that under requirements of P.A. 74, Michigan P.A. of 1970, the corner points mentioned in lines 1 and 2 above were in conformance with regulations and rules therefore as required in the current manual of survey instructions of the United States Department of the Interior, Bureau of Land Management or by a decree of a Court of Law and/or that the corner points mentioned in lines 3, 4 and 5 above were in conformance with the rules of the Michigan Board of Land Surveyors or by a Decree of a Court of Law, established, re-established, monumented, re-monumented, recovered, found as expressed below:

NOTE: Not more than 4 corners, all in the same town and range, may be recorded on this certificate.

A. Description of original monument and accessories and/or subsequent restoration:

L. LYON SET POST
1830 MAPLE 12 N68W 39
ALDER 4 N14E 13

SURVEY & REMONUMENTATION

MAR 06 1998

01/02/98 111#7267 A99
CORNER \$9.00
01/02/98 111#7267 A99
STATE REMON FEE \$2.00

A	B	C	D	E	F	G	H	I	J	K	L	M
2	6	5	4	3	2	1						
3												
4	7	8	9	10	11	12						
5												
6	18	17	16	15	14	13						
7												
8	19	20	21	22	23	24						
9												
10	30	29	28	27	26	25						
11												
12	31	32	33	34	35	36						
13												

B. Description of corner evidence found and/or method applied in restoring or reestablishing corner:

C. BARGER FOUND 1" BAR
AUG 1997
P.K. IN W SIDE 48" POPULAR S10DEGW 34.41'
P.K. IN PP N40DEG54'E 44.0'
P.K. IN PP N30DEG30'W 41.95'
P.K. IN PP S8DEG25'E 28.65'

98 JAN -2 PM 3:00


BERNICE TRETHERWAY
REGISTER OF DEEDS
BERRIEN COUNTY, MICHIGAN

C. Description of monument for corner and accessories established to perpetuate locating the position of the corner:

H-13 1" PIPE 36" LONG WITH 2 1/2" REMONUMENTATION BRASS CAP IN MONUMENT BOX
WITNESS TAG IN W SIDE 48" POPULAR S10DEGW 34.41'
WITNESS TAG IN PP N40DEG54'E 44.0'
WITNESS TAG IN PP N30DEG30'W 41.95'
WITNESS TAG IN PP S8DEG25'E 28.65'

AND IS ACCEPTED AS A CAREFUL AND FAITHFUL PERPETUATION OF THE POSITION OF THE ORIGINAL CORNER.

Signed by Charles W. Barger Date OCTOBER 31, 1997
Surveyor's Michigan License No. 31589

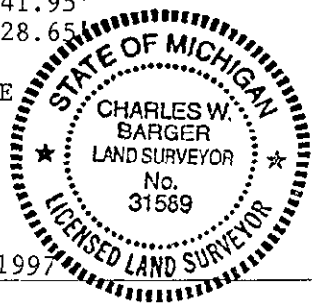

BARGER ENGINEERING, INC.
BERRIEN COUNTY REMONUMENTATION

NORTH QUARTER CORNER SECTION 3, TOWNSHIP 6 SOUTH, RANGE 19 WEST
(H-13)

LANDON ROAD & BROWNTOWN ROAD

L. Lyon
1830

Set Post
Maple 12 N68w 39
Alder 4 N14E 13

Berrien County
Road Commission
1940-1959

No Record

Strebs
?

Survey A4461
Shows Existing Corner

R. Garrett
July 1972

Iron Pipe
PP N40degW 41.7'
Guy Pole N45degE 43.5'
24" Elm S 33.7'

C. Barger
Aug 1997

1" Bar
P.K. in W. Side 48" Popular S10degW 34.41'
P.K. in PP N40deg54'E 44.0'
P.K. in PP N30deg30'W 41.95'
P.K. in PP S8deg25'E 28.65'

SURVEY &
REMONUMENTATION

MAR 06 1998

SECTION

JOB ASSIGNMENT 1997-02-0300

LIBER 4 PAGE 18

LIBER 4 PAGE 59