

ATTESTED BY THE BERRIEN COUNTY SURVEY PEER GROUP AS THE OFFICIAL CORNER UNDER MICHIGAN PUBLIC ACT 345 OF 1990

RECORDED

Berrien County Remonumentation
LAND CORNER RECORDATION CERTIFICATE
 Filing Requirement of Act 74, Mich. P.A. 1970

Dec 26 11 46 AM '96

Handwritten signature
 For corners in

Handwritten signature
 REGISTER OF DEEDS
 BERRIEN COUNTY, MICHIGAN

Berrien (County) Located In: Corner Code #

1. Public Land Survey	T	7S	R	19W	I1
COMMON TO T6S, R19W I13	T		R		I-13
	T		R		
	T		R		
2. Property Controlling in Section	S		T		
	S		T		
3. Miscellaneous Property in Sec.	S		T		
	S		T		

4. Lot No. _____, Recorded Plat _____
 5. Private Claims _____

12/26/96 111#9871 A99
 CORNER \$9.00
 12/26/96 111#9871 A99
 STATE REMON FEE \$2.00
Register of Deeds Stamp & File Number

	A	B	C	D	E	F	G	H	I	J	K	L	M
2	6	5	4	3	2	1							
3													
4	7	8	9	10	11	12							
5													
6	18	17	16	15	14	13							
7													
8	19	20	21	22	23	24							
9													
10	30	29	28	27	26	25							
11													
12	31	32	33	34	35	36							
13													

I, Charles W. Barger, in a field survey on December, 19 96, do hereby certify that under requirements of P.A. 74, Michigan P.A. of 1970, the corner points mentioned in lines 1 and 2 above were in conformance with regulations and rules therefore as required in the current manual of survey instructions of the United States Department of the Interior, Bureau of Land Management or by a decree of a Court of Law and/or that the corner points mentioned in lines 3, 4 and 5 above were in conformance with the rules of the Michigan Board of Land Surveyors or by a Decree of a Court of Law; established, re-established, monumented, re-monumented, recovered, found as expressed below:

NOTE: Not more than 4 corners, all in the same town and range, may be recorded on this certificate.


A. Description of original monument and accessories and/or subsequent restoration:
 July 1829 NORTH BOUNDARY POST IN MARSH
 L. Lyons

B. Description of corner evidence found and/or method applied in restoring or reestablishing corner:
 June, 1996 Found Iron in Pavement
 C. Barger SW Corner N. Headwall in Bridge N70°15'E 45.1'
 NW Corner S. Headwall in Bridge S70°15'E 44.6'
 P.K. in Power Pole S46°30'E 46.15'
 P.K. in Power Pole S67°W. 80.15'

SURVEY &
 REMONUMENTATION
 MAY 20 1997
 COMMISSIONER

C. Description of monument for corner and accessories established to perpetuate locating the position of the corner:
 I1 1"pipe 36"long with 2½" Remonumentation Brass Cap in Monument Box
 SW Corner N. Headwall in Bridge N70°15'E 45.1'
 NW Corner S. Headwall in Bridge S70°15'E 44.6'
 Witness Tag in Power Pole S46°30'E 46.15'
 Witness Tag in Power Pole S67°W 80.15'

And is accepted as a careful and faithful perpetuation of the position of the original corner.

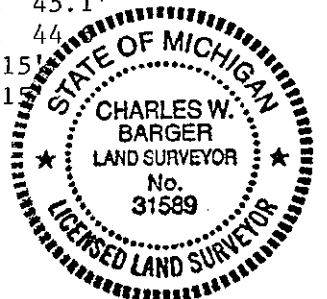

Signed by Charles W. Barger Date December 19, 1996

Surveyor's Michigan License No. #31589

BARGER ENGINEERING, INC.
BERRIEN COUNTY REMONUMENTATION

NORTHWEST CORNER SECTION 2, TOWNSHIP 7 SOUTH, RANGE 19 WEST
NORTHEAST CORNER SECTION 3, TOWNSHIP 7 SOUTH, RANGE 19 WEST
SOUTHEAST CORNER SECTION 34, TOWNSHIP 6 SOUTH, RANGE 19 WEST
SOUTHWEST CORNER SECTION 35, TOWNSHIP 6 SOUTH, RANGE 19 WEST

II
CLEVELAND & BROWNTOWN

JULY 1829 NORTH BOUNDARY AT POST IN MARSH
L. LYONS

BCRC NOTES IRON IN PAVEMENT
NO DATE 40' WEST & 1' SOUTH OF WEST POST OF S. RAIL OF BRIDGE
CORNER FENCE POST NW 38.2'
CORNER FENCE POST SOUTH 14.2'
4" ASH N70°W 43.7'

C. BARGER FOUND IRON IN PAVEMENT
JUNE 18, 1996 SW CORNER N. HEADWALL IN BRIDGE N70°15'E 45.1'
NW CORNER S. HEADWALL IN BRIDGE S70°15'E 44.6'
P.K. IN POWER POLE S46°30'E 46.15'
P.K. IN POWER POLE S67°W 80.15'

AUGUST 1977 RECORDED SURVEY - LIBER 1056, PAGE 242
R. PRESTINE FOUND RR SPIKE (USED BY OTHERS)
C/L CLEVELAND AVENUE WEST 11.0'
SW COR BRIDGE S70°E 44.65'
NW COR BRIDGE N70°E 45.1'

SURVEY &
REMONUMENTATION

MAY 20 1997

COMMISSION