

RATIFIED BY THE BERRIEN COUNTY SURVEY PEER GROUP AS THE OFFICIAL CORNER UNDER MICHIGAN PUBLIC ACT 345 OF 1990

09/02/94

111#2445 A33
CORNER \$9.00

09/02/94

111#2445 A33
STATE REMON FEE \$2.00

BERRIEN COUNTY REMONUMENTATION LAND CORNER RECORDATION CERTIFICATE
Filing Requirement of Act 74, Mich. P.A. 1970

REGISTERED LAND SURVEYOR
MICHAEL COUNTY MICHIGAN

SEP 2 4 21 PM '94

RECORDED

For corners in _____

Berrien (County)	Located In:	Corner Code #
1. Public Land Survey	T 6S R 19W	M-3
	T _____ R _____	_____
	T _____ R _____	_____
	T _____ R _____	_____
2. Property Controlling in Section	S _____ T _____ R _____	_____
	S _____ T _____ R _____	_____
3. Miscellaneous Property in Sec.	S _____ T _____ R _____	_____
	S _____ T _____ R _____	_____
4. Lot No. _____, Recorded Plat _____		
5. Private Claims _____		

Register of Deeds Stamp & File Number

I, John G. Kamer, in a field survey on August 25, 19 94, do hereby certify that under requirements of P.A. 74, Michigan P.A. of 1970, the corner points mentioned in lines 1 and 2 above were in conformance with regulations and rules therefore as required in the current manual of survey instructions of the United States Department of the Interior, Bureau of Land Management or by a decree of a Court of Law and/or that the corner points mentioned in lines 3, 4 and 5 above were in conformance with the rules of the Michigan Board of Land Surveyors or by a Decree of a Court of Law; established, re-established, monumented, re-monumented, recovered, found as expressed below:

	A	B	C	D	E	F	G	H	I	J	K	L	M
2	6		5		4		3		2		1		
3													
4	7		8		9		10		11		12		
5													
6	18		17		16		15		14		13		
7													
8	19		20		21		22		23		24		
9													
10	30		29		28		27		26		25		
11													
12	31		32		33		34		35		36		
13													

NOTE: Not more than 4 corners, all in the same town and range, may be recorded on this certificate.

A. Description of original monument and accessories and/or subsequent restoration:
(See Back)

SURVEY & REMONUMENTATION


NOV 07 1994

COMMISSION

B. Description of corner evidence found and/or method applied in restoring or reestablishing corner:
Found S.W. cor. sec. 6 in mon. box 8.58' south which agrees with older survey notes and BCRC notes.
Found witness ties from 1948 - 1960 BCRC for SW cor. of sec. 6.
Set SE cor. sec. 1 on line and 8.58' N. of SW cor. of sec. 6.
Also agrees with occupation to the west.

C. Description of monument for corner and accessories established to perpetuate locating the position of the corner:
Set monument box with standard 3' x 1" pipe and brass plate.
No other markers found during excavation for box.
Corner is accepted as a careful and faithful perpetuation of the position of the original corner.
Nail w/tag PP S6°E 223.46
Nail w/tag PP S11°W 219.42
Nail w/tag PP S73°W 26.24
Monument box 3 1/4" iron pipe south 8.58
(SW corner sec. 6)

Signed by John G. Kamer
Surveyor's Michigan License No. 27449

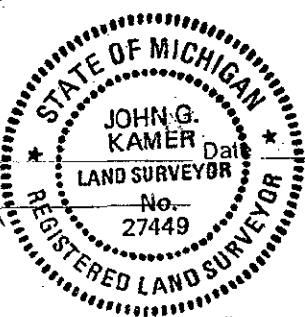

9-02-94

1830 Lucius Lyon
80.00 Set Post Com to Secs 1 & 12 (6-19)
Ash 9 S 80 1/2 W 68
Elm 12 N 25 W 28

1845 J.H. Dewey
Conc. Post W 25.0'
Elec. Pole E 27.2'

Dec. 1948 to Jan 1960 BCRC
Elec. Guy Pole E. 27.2
10" W. Cherry NE 59.7'

June 24, 1970 W & A
SE Cor. to S 1/4 Cor.
2631.5'

April 2, 1973 W & A
Mon Box
1" IP

July 18, 1972 Garrett (W&A)
Fnd. Mon. Box
Guy Pole East 27.3
PP West 25.6'
PP N 20° W 192.0

April 9, 1976 W & A
8.58' South to SW Cor. of 6-6-18

March 3, 1978 Richardson - R W Petrie
Guy Pole East 27.3
PP West 25.6'
PP N 20° W 192.0