

RAISED BY THE BERRIEN COUNTY SURVEY PEER GROUP AS THE OFFICIAL CORNER UNDER MICHIGAN PUBLIC ACT 345 OF 1990

09/02/94 111#2445 A33
 CORNER \$9.00
 09/02/94 111#2445 A33
 STATE REMON FEE \$2.00

BERRIEN COUNTY REMONUMENTATION LAND CORNER RECORDATION CERTIFICATE
 Filing Requirement of Act 74, Mich. P.A. 1970

W. J. ...
 8-18-94

REGISTER OF DEEDS
 BERRIEN COUNTY MICHIGAN
 SEP 2 4 21 PM '94
 RECORDED

For corners in Berrien (County) Located In: _____ Corner Code =# _____

| | | |
|------------------------------------|--------------------------|------------|
| 1. Public Land Survey | T <u>6S</u> R <u>19W</u> | <u>M-4</u> |
| | T _____ R _____ | _____ |
| | T _____ R _____ | _____ |
| | T _____ R _____ | _____ |
| 2. Property Controlling in Section | S _____ T _____ R _____ | _____ |
| | S _____ T _____ R _____ | _____ |
| 3. Miscellaneous Property in Sec. | S _____ T _____ R _____ | _____ |
| | S _____ T _____ R _____ | _____ |

4. Lot No. _____, Recorded Plat _____

5. Private Claims _____

Register of Deeds Stamp & File Number

| | A | B | C | D | E | F | G | H | I | J | K | L | M |
|----|----|---|----|---|----|---|----|---|----|---|----|---|---|
| 2 | 6 | | 5 | | 4 | | 3 | | 2 | | 1 | | |
| 3 | | | | | | | | | | | | | |
| 4 | 7 | | 8 | | 9 | | 10 | | 11 | | 12 | | |
| 5 | | | | | | | | | | | | | |
| 6 | 18 | | 17 | | 16 | | 15 | | 14 | | 13 | | |
| 7 | | | | | | | | | | | | | |
| 8 | 19 | | 20 | | 21 | | 22 | | 23 | | 24 | | |
| 9 | | | | | | | | | | | | | |
| 10 | 30 | | 29 | | 28 | | 27 | | 26 | | 25 | | |
| 11 | | | | | | | | | | | | | |
| 12 | 31 | | 32 | | 33 | | 34 | | 35 | | 36 | | |
| 13 | | | | | | | | | | | | | |

I, John G. Kamer, in a field survey on August 25, 1994, do hereby certify that under requirements of P.A. 74, Michigan P.A. of 1970, the corner points mentioned in lines 1 and 2 above were in conformance with regulations and rules therefore as required in the current manual of survey instructions of the United States Department of the Interior, Bureau of Land Management or by a decree of a Court of Law and/or that the corner points mentioned in lines 3, 4 and 5 above were in conformance with the rules of the Michigan Board of Land Surveyors or by a Decree of a Court of Law; established, re-established, monumented, re-monumented, recovered, found as expressed below:

NOTE: Not more than 4 corners, all in the same town and range, may be recorded on this certificate.

A. Description of original monument and accessories and/or subsequent restoration:

(See Back)

SURVEY &
 REMONUMENTATION
 NOV 07 1994
 COMMISSION


B. Description of corner evidence found and/or method applied in restoring or reestablishing corner:

Found 5/8" iron in mon. box

C. Description of monument for corner and accessories established to perpetuate locating the position of the corner:

M-4
 Set standard 3' pipe w/brass plate in existing mon. box
 Remove 5/8"x24" iron rod
 Corner is accepted as a careful and faithful perpetuation of the original corner.
 Set 8 penny nail w/tag in p. pole S23°W 69.60'
 Set 8 penny nail w/tag in grape post N76°W 27.78'
 Set 8 penny nail w/tag in grape post S57°W 42.33'
 W 1/4 cm, 7-16-18 North 4 281

Signed by John G. Kamer
 Surveyor's Michigan License No. 27449
 LIBER 3 PAGE 147

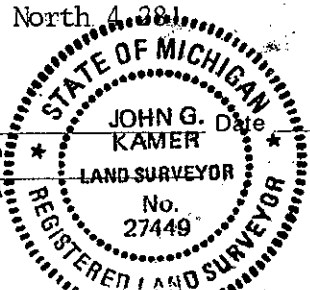

9-01-94

1830

Lucius Lyon
40.00 Set Post (Com to Secs 12-6-19 & 7-6-18)
Beech 20 S 38 W 29
Beech 7 N 42 W 30

1945

J.H. Dewey
3" Pear SE 38"
43" North of Oronoko Cor.

July 18, 1972

W & A
Fnd. Box
15" Apple S 50° E 38.5
Power Pole S 25° W 73.3
End Grape Post N 85° W 26.9'

March 14, 1974

Garrett (W & A)
Fnd. Mon. Box w/iron
Same witnesses as above
2638.73' to SE Cor.