

RAISED BY THE BERRIEN COUNTY  
 SURVEY PEER GROUP AS THE  
 OFFICIAL CORNER UNDER MICHIGAN  
 PUBLIC ACT 315 OF 1990  
*John G. Kamer*  
 4-25-95

11/29/95 11182012 RT7 \$9.00  
 11/29/95 11182312 RT7 STATE ADMIN FEE \$2.00

BERRIEN COUNTY REMONUMENTATION  
**LAND CORNER RECORDATION CERTIFICATE**  
 Filing Requirement of Act 74, Mich. P.A. 1970

For corners in

BERRIEN (County)	Located In:	Corner Code #
1. Public Land Survey	T <u>6S</u> R <u>19W</u>	<u>M-9</u>
	T _____ R _____	_____
	T _____ R _____	_____
	T _____ R _____	_____
2. Property Controlling in Section	S _____ T _____ R _____	_____
	S _____ T _____ R _____	_____
3. Miscellaneous Property in Sec.	S _____ T _____ R _____	_____
	S _____ T _____ R _____	_____
4. Lot No. _____, Recorded Plat _____		
5. Private Claims _____		

RECORDED  
 Nov 29 3 39 PM '95  
*Bernice T. ...*  
 REGISTER OF DEEDS  
 BERRIEN COUNTY MICHIGAN  
 Register of Deeds Stamp & File Number

	A	B	C	D	E	F	G	H	I	J	K	L	M
2	6	5	4	3	2	1							
3													
4	7	8	9	10	11	12							
5													
6	18	17	16	15	14	13							
7													
8	19	20	21	22	23	24							
9													
10	30	29	28	27	26	25							
11													
12	31	32	33	34	35	36							
13													

I, JOHN G. KAMER, in a field survey on NOVEMBER 16, 19 95, do hereby certify that under requirements of P.A. 74, Michigan P.A. of 1970, the corner points mentioned in lines 1 and 2 above were in conformance with regulations and rules therefore as required in the current manual of survey instructions of the United States Department of the Interior, Bureau of Land Management or by a decree of a Court of Law and/or that the corner points mentioned in lines 3, 4 and 5 above were in conformance with the rules of the Michigan Board of Land Surveyors or by a Decree of a Court of Law; established, re-established, monumented, re-monumented, recovered, found as expressed below:

**NOTE: Not more than 4 corners, all in the same town and range, may be recorded on this certificate.**


A. Description of original monument and accessories and/or subsequent restoration:  
 (SEE BACK.)

B. Description of corner evidence found and/or method applied in restoring or reestablishing corner:  
 FOUND ANGLE IRON 3' ABOVE GROUND. THE PERPETUATION OF THE CORNER AS EVIDENCED BY THE HISTORY OF WITNESS TIES APPEARS RELIABLE AND ACCURATE.

C. Description of monument for corner and accessories established to perpetuate locating the position of the corner:  
 REMOVED 3' HIGH ANGLE IRON.  
 SET STANDARD 3' X 4" CONCRETE MONUMENT WITH BRASS PLATE. ALSO SET CARSONITE MARKER IN VICINITY OF CORNER.  
 SET NAIL W/TAG IN 7" HICKORY, S 14° W 12.90'  
 SET NAIL W/TAG IN 5" WILD CHERRY, N 57° W 18.78'  
 SET NAIL W/TAG IN 25" HICKORY N 08° E 18.06'  
 SET NAIL W/TAG IN 15" TWIN HICKORY S 25° E 1.23'  
 CORNER IS ACCEPTED AS A CAREFUL AND FAITHFUL PERPETUATION OF THE POSITION OF THIS ORIGINAL CORNER.  
 CORNER A-9 OF 6-19 IS 4.62 FEET SOUTH.

SURVEY &  
 REMONUMENTATION  
 MAR 27 1996  
 COMMISSION

Signed by *John G. Kamer*  
 Surveyor's Michigan License No. 27449

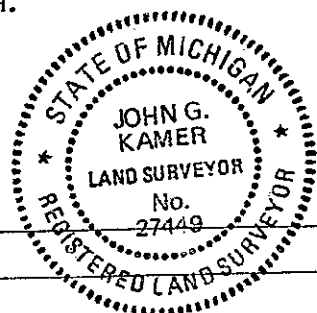

Date 11-29-95

**Baroda Township (T 6 S, R 19 W)  
SE Cor. Sec 24 (M-9)**

**July, 1829**

Lucius Lyon, D.S.  
(From South) 80.00 Set Post Corner to Sec's 24 & 25  
W. Oak 8 N 28 W 22  
W. Oak 7 S 81 W 33

**Circa 1940±**

J.H.Dewey, Range Book  
Shows 4.6' Jog to S. for Sections to the East  
No Witness Ties

**Circa 1959±**

G.L. Wightman - Notes  
Corner Gone & Cor. 4.62' S. Gone  
Used Conc. Post 33' W. & Irons S. & Mon. S. 1323.7' to  
Reestablish Location of Corner

**April 21, 1977**

M.R. Rushlow - W&A - Survey  
No Witnesses  
Broken Conc. Post 1323.7' S.

**July 6, 1977**

Robert Beland - Survey  
Shows NE Cor. - No Witnesses

**1982±**

Stefan - Survey  
Shows Corner - No Witnesses

**May 23, 1983  
May 16, 1987**

J.G. Kamer - W&A  
Found 3' Steel Post  
PK in Fence Post W 2.5'  
PK in Twin 6" Hickory  
S 45° E 1.0'  
PK in Fence Post N 80° E 5.3'