

RATIFIED BY THE BERRIEN COUNTY SURVEY PEER GROUP AS THE OFFICIAL CORNER UNDER MICHIGAN PUBLIC ACT 348 OF 1990

*[Signature]*  
10-23-97

For corners in BERRIEN (County)

RE RECORDED TO CORRECT TOWNSHIP BERRIEN COUNTY REMONUMENTATION  
**LAND CORNER RECORDATION CERTIFICATE**  
Filing Requirement of Act 74, Mich. P.A. 1970

RECORDED

97 OCT 31 PM 2:04

BERNICE TRETHERWAY  
REGISTER OF DEEDS  
BERRIEN COUNTY, MICHIGAN

Located In: \_\_\_\_\_ Corner Code H-13

1. Public Land Survey T 6 R 19  
Common to: T75, R19W, H-1  
T \_\_\_\_\_ R \_\_\_\_\_  
T \_\_\_\_\_ R \_\_\_\_\_  
T \_\_\_\_\_ R \_\_\_\_\_  
T \_\_\_\_\_ R \_\_\_\_\_

2. Property Controlling S \_\_\_\_\_ T \_\_\_\_\_ R \_\_\_\_\_  
in Section S \_\_\_\_\_ T \_\_\_\_\_ R \_\_\_\_\_

3. Miscellaneous S \_\_\_\_\_ T \_\_\_\_\_ R \_\_\_\_\_  
Property in Sec. S \_\_\_\_\_ T \_\_\_\_\_ R \_\_\_\_\_

4. Lot No. \_\_\_\_\_, Recorded Plat \_\_\_\_\_

5. Private Claims \_\_\_\_\_

10/31/97  
10/31/97  
Register of Deeds Stamp & File Number

I, CHARLES W. BARGER, in a field survey on OCTOBER, 19 97, do hereby certify that under requirements of P.A. 74, Michigan P.A. of 1970, the corner points mentioned in lines 1 and 2 above were in conformance with regulations and rules therefore as required in the current manual of survey instructions of the United States Department of the Interior, Bureau of Land Management or by a decree of a Court of Law and/or that the corner points mentioned in lines 3, 4 and 5 above were in conformance with the rules of the Michigan Board of Land Surveyors or by a Decree of a Court of Law, established, re-established, monumented, re-monumented, recovered, found as expressed below:

**NOTE: Not more than 4 corners, all in the same town and range, may be recorded on this certificate.**

A. Description of original monument and accessories and/or subsequent restoration:

L. LYON SET POST  
1830 MAPLE 12 N68W 39  
ALDER 4 N14E 13

**SURVEY & REMONUMENTATION**

**MAR 06 1998**

01/02/98 111#7267 A99  
CORNER \$9.00  
01/02/98 111#7267 A99  
STATE REMON FEE \$2.00

A	B	C	D	E	F	G	H	I	J	K	L	M
2	6	5	4	3	2	1						
3												
4	7	8	9	10	11	12						
5												
6	18	17	16	15	14	13						
7												
8	19	20	21	22	23	24						
9												
10	30	29	28	27	26	25						
11												
12	31	32	33	34	35	36						
13												

B. Description of corner evidence found and/or method applied in restoring or reestablishing corner:

C. BARGER FOUND 1" BAR  
AUG 1997  
P.K. IN W SIDE 48" POPULAR S10DEGW 34.41'  
P.K. IN PP N40DEG54'E 44.0'  
P.K. IN PP N30DEG30'W 41.95'  
P.K. IN PP S8DEG25'E 28.65'


98 JAN -2 PM 3:00

BERNICE TRETHERWAY  
REGISTER OF DEEDS  
BERRIEN COUNTY, MICHIGAN

C. Description of monument for corner and accessories established to perpetuate locating the position of the corner:

H-13 1" PIPE 36" LONG WITH 2 1/2" REMONUMENTATION BRASS CAP IN MONUMENT BOX  
WITNESS TAG IN W SIDE 48" POPULAR S10DEGW 34.41'  
WITNESS TAG IN PP N40DEG54'E 44.0'  
WITNESS TAG IN PP N30DEG30'W 41.95'  
WITNESS TAG IN PP S8DEG25'E 28.65'

AND IS ACCEPTED AS A CAREFUL AND FAITHFUL PERPETUATION OF THE POSITION OF THE ORIGINAL CORNER.

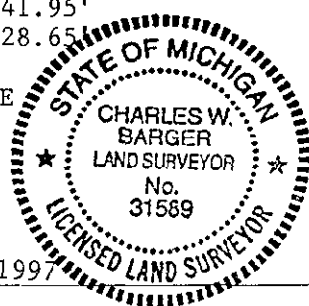

Signed by Charles W. Barger Date OCTOBER 31, 1997  
Surveyor's Michigan License No. 31589