

RATIFIED BY THE BERRIEN COUNTY SURVEY PEER GROUP AS THE OFFICIAL CORNER UNDER MICHIGAN PUBLIC ACT 345 OF 1990

10/20/95 111#9405 A33
 CORNER \$7.00
 10/20/95 111#9405 A33
 STATE REMON FEE \$2.00

LAND CORNER RECORDATION CERTIFICATE
 Filing Requirement of Act 74, Mich. P.A. 1970
 BERRIEN COUNTY REMONUMENTATION

RECORDED
 OCT 20 2 10 PM '95
 REGISTER OF DEEDS
 BERRIEN COUNTY MICHIGAN

For corners in BERRIEN (County) Located in: _____ Corner Code # A-5

1. Public Land Survey	T <u>7</u> R <u>17</u>	<u>A-5</u>
	T _____ R _____	_____
	T _____ R _____	_____
	T _____ R _____	_____
2. Property Controlling in Section	S _____ T _____ R _____	_____
	S _____ T _____ R _____	_____
3. Miscellaneous Property in Sec.	S _____ T _____ R _____	_____
	S _____ T _____ R _____	_____

Register of Deeds Stamp & File Number

4. Lot No. _____, Recorded Plat _____
 5. Private Claims _____

	A	B	C	D	E	F	G	H	I	J	K	L	M
2	6	5	4	3	2	1							
3													
4	7	8	9	10	11	12							
5													
6	18	17	16	15	14	13							
7													
8	19	20	21	22	23	24							
9													
10	30	29	28	27	26	25							
11													
12	31	32	33	34	35	36							
13													

I, DALE L. KESLER, in a field survey on SEPTEMBER 26, 19 95, do hereby certify that under requirements of P.A. 74, Michigan P.A. of 1970, the corner points mentioned in lines 1 and 2 above were in conformance with regulations and rules therefore as required in the current manual of survey instructions of the United States Department of the Interior, Bureau of Land Management or by a decree of a Court of Law and/or that the corner points mentioned in lines 3, 4 and 5 above were in conformance with the rules of the Michigan Board of Land Surveyors or by a Decree of a Court of Law; established, re-established, monumented, re-monumented, recovered, found as expressed below:

NOTE: Not more than 4 corners, all in the same town and range, may be recorded on this certificate.

A. Description of original monument and accessories and/or subsequent restoration:

- 12-06-1835 - Robert Clark - Set post - Intersect west boundary 36 Links (23.76') north of post corner of Sections 12 & 13, T8S, R18W. - 15" Beech, S. 37° E 17 Links - 4" Beech - N. 71 1/2° E. 14 Links
- Feb. 1980 - Robert Prestine - Found Berrien Co. Road Commission plug, face of angle iron fence post N. 48° E. 39.0' - Center of 44" Maple S. 28° E. 58.0' Center of electric pole S. 42° W. 38.1' - Measured S. 24.2' to Buchanan corner.
- Mar. 1982 - Barger Engineering - Found plug.


B. Description of corner evidence found and/or method applied in restoring or reestablishing corner:

Found 5/8" iron bar in monument box.
 The accessories of the 1980 survey by Robert Prestine verify location of corner. Accepted 5/8" iron bar as best evidence of corner.

WILSON &
 MONUMENTATION
 MAR 27 1996
 COMMISSION

C. Description of monument for corner and accessories established to perpetuate locating the position of the corner:

Set 3/4" iron pipe 3' long with brass plate in place of 5/8" iron bar in monument box and is accepted as a careful and faithful perpetuation of the original corner.
 Center of electric pole (nail w/washer) S. 42°00' W. 38.10'
 Set nail w/washer in 8" Maple tree - S. 45° E. 64.45'
 Set nail w/washer in 6" Maple tree - S. 22°00' W. 101.00'
 M-5, T 7 S, R 18 W - South 23.76'

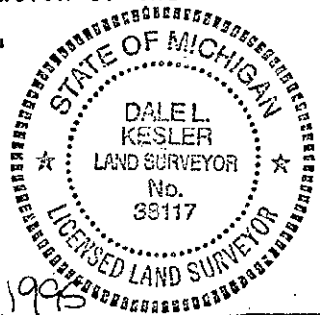

Signed by Dale L Kesler

Date October 6, 1995