

RAITIFIED BY THE BERRIEN COUNTY SURVEY PEER GROUP AS THE OFFICIAL CORNER UNDER MICHIGAN PUBLIC ACT 345 OF 1990

12/19/96 9614 13
 12/19/96 111#9614 A33
 STATE REMON FEE \$2.00

Dale Kesler
 11-A-96
 For corners in BERRIEN (County)

LAND CORNER RECORDATION CERTIFICATE
Filing Requirement of Act 74, Mich. P.A. 1970
BERRIEN COUNTY REMONUMENTATION

- Located In: _____ Corner Code # _____
- Public Land Survey T 7S R 17W I-1
 T _____ R _____
 T _____ R _____
 T _____ R _____
 - Property Controlling in Section S _____ T _____ R _____
 S _____ T _____ R _____
 - Miscellaneous Property in Sec. S _____ T _____ R _____
 S _____ T _____ R _____
 - Lot No. _____, Recorded Plat _____
 - Private Claims _____

RECORDED
 DEC 19 2 14 PM '96
 REGISTER OF DEEDS STAMP & FILE NUMBER

	A	B	C	D	E	F	G	H	I	J	K	L	M
2	6	5	4	3	2								
3													
4	7	8	9	10	11	12							
5													
6	18	17	16	15	14	13							
7													
8	19	20	21	22	23	24							
9													
10	30	29	28	27	26	25							
11													
12	31	32	33	34	35	36							
13													

I, DALE L. KESLER, in a field survey on OCTOBER 24, 19 96, do hereby certify that under requirements of P.A. 74, Michigan P.A. of 1970, the corner points mentioned in lines 1 and 2 above were in conformance with regulations and rules therefore as required in the current manual of survey instructions of the United States Department of the Interior, Bureau of Land Management or by a decree of a Court of Law and/or that the corner points mentioned in lines 3, 4 and 5 above were in conformance with the rules of the Michigan Board of Land Surveyors or by a Decree of a Court of Law, established, re-established, monumented, re-monumented, recovered, found as expressed below:

NOTE: Not more than 4 corners, all in the same town and range, may be recorded on this certificate.


- A. Description of original monument and accessories and/or subsequent restoration:
- July 11, 1827 - William Brookfield - Measured North 76.76 Chains. Intersected North Boundary 1.43 Chains west of Post - Witnesses - 6" Sugar S. 47 1/2° E. 21 Links - 15" Beech S. 48° W. 19 Links
 - March 23, 1874 - Silas Ireland - Dep. County Surveyor, Bk. 1, Pg. 44, Found Sec. Corner Found both witnesses, took new one - 16" Sugar S. 58° E. 52 Links
 - Feb. 1, 1876 - Thomas Love - Found NW Corner of Section, Bk. 2, Pg. 35, Witnesses - 12" Sugar S. 60° E. 51 1/2 Links - 12" Sugar N. 80° E. 7 Links
 - No Date - Robert Prestine - Found stone - Witness for corner - 36" Stump N.70° W.16.0' - 38" Stump S.88° E.27.0' - Measured East 71.7' to fence line running South.

B. Description of corner evidence found and/or method applied in restoring or reestablishing corner:

Found Stone at the Northwest Corner Section 2, T7S, R17W. Measured East 71.7' to fence line running South. Property description Recorded in Liber 1765, Page 948, describes property line 71.6' East of the West Section line of the Northwest Quarter, Sec. 2.

SURVEY & REMONUMENTATION
 MAY 20 1997
 COMMISSIONER

- C. Description of monument for corner and accessories established to perpetuate locating the position of the corner:
- Set Concrete monument with brass plate in place of stone and is accepted as a careful and faithful perpetuation of the position of the original corner.
- Southeast corner Sec. 34, T6S, R17W - East 94.40'
 - Nail w/tag in 10" Maple - N. 3° W. 26.20'
 - Nail w/tag in 12" Maple - S. 70° E. 23.30'
 - Nail w/tag in 12" Cherry - S. 10° W. 30.00'

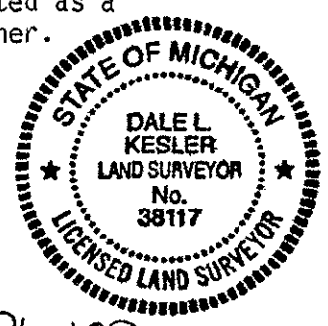

Signed by *Dale Kesler* Date December 9, 1996
 Surveyor's Michigan License No. 38117