

RECORDED

RATIFIED BY THE BERRIEN COUNTY SURVEY PEER GROUP AS THE OFFICIAL CORNER UNDER MICHIGAN PUBLIC ACT 345 OF 1990

Berrien County Remonumentation LAND CORNER RECORDATION CERTIFICATE Filing Requirement of Act 74, Mich. P.A. 1970

98 OCT 27 PM 1:06 BERNICE TRETHERWAY REGISTER OF DEEDS BERRIEN COUNTY, MICHIGAN

For corners in 9-10-98

Table with columns: Berrien (County), Located In:, Corner Code #. Rows include Public Land Survey, Property Controlling in Section, Miscellaneous Property in Sec., Lot No., and Private Claims.

10/27/98 111#4091 A44 CORNER \$9.00 10/27/98 111#4091 A44 Register of Deeds Stamp & File Number STATE REMON FEE \$2.00

Grid table with columns A-M and rows 2-13. Contains numerical values for each cell, likely representing a survey grid.

I, Charles W. Barger in a field survey on July 19 98 do hereby certify that under requirements of P.A. 74, Michigan P.A. of 1970, the corner points mentioned in lines 1 and 2 above were in conformance with regulations and rules therefore as required in the current manual of survey instructions of the United States Department of the Interior, Bureau of Land Management or by a decree of a Court of Law and/or that the corner points mentioned in lines 3, 4 and 5 above were in conformance with the rules of the Michigan Board of Land Surveyors or by a Decree of a Court of Law; established, re-established, monumented, re-monumented, recovered, found as expressed below:


NOTE: Not more than 4 corners, all in the same town and range, may be recorded on this certificate.

A. Description of original monument and accessories and/or subsequent restoration: W. Brookfield 1827 Set Post Lynn 5 S61DW 8 W. Ash 9 N 7 1/2 W 19

B. Description of corner evidence found and/or method applied in restoring or reestablishing corner: C. Barger July 1998 Found Square Headed Iron Bolt 3/4" Shaft & 2" Square Head Found 1/2" Iron Pipe N0dE 31.6' Found Wit Tag in Pst N0dE 29.09' Found Wit Tag in Fence Brake N23d08'W 19.73'

SURVEY & REMONUMENTATION NOV 20 1998 SECTION

C. Description of monument for corner and accessories established to perpetuate locating the position of the corner: M6 - 1" pipe 36" long with 2 1/2" Remonumentation Brass Cap in Monument Box Found 1/2 Iron Pipe N0dE 31.6' Found Wit Tag in Pst N0dE 29.09' Found Wit Tag in Fence Brake N23d08'W 19.73' Set Witness Tag in Twin Poplar S20dE 11.69' Set Witness Tag in Poplar S50dW 21.81'

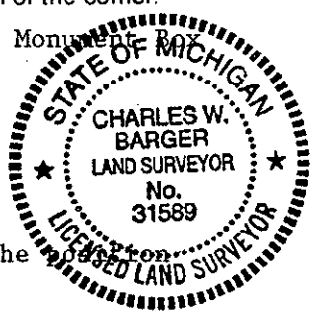

And is accepted as a careful and faithful perpetuation of the of the original corner.

Signed by Charles W. Barger Date October 6, 1998 Surveyor's Michigan License No. 31589

BERRIEN COUNTY REMONUMENTATION  
1998-02-0334

EAST QUARTER CORNER SECTION 13, TOWNSHIP 7 SOUTH, RANGE 17 WEST  
T7S, R17W, M-6

W. Brookfield  
1827

Set Post  
Lynn 5 S61dW 8  
W. Ash 9 N7-1/2W 19

N.C. Jones  
1971

Found Square Headed Iron Bolt 3/4" shaft  
& 2" square head  
Telegraph Pole N56dE 14.51'  
Fe Cor Post N 28.79'  
5" Triple Elm N2dW 12.97'  
6" Elm S9dW 34.32'  
Fe Post (Brace) N21dW 19.64'  
Recorded Corner 9/29/72

C. Barger  
July 1998

Found Square Headee Iron Bolt 3/4" Shaft  
& 2" square head  
Found 1/2" Iron Pipe N0dE 31.6'  
Found Wit Tag in Pst N0dE 29.09'  
Found Wit Tag in Fence Brake N23d08'W  
19.73'

98389.01

SURVEY &  
REMONUMENTATION

NOV 20 1998

SECTION