

MAINTAINED BY THE BERRIEN COUNTY SURVEY PEER GROUP AS THE OFFICIAL CORNER UNDER MICHIGAN PUBLIC ACT 345 OF 1990

RECORDED

98 OCT 27 PM 1:06
LAND CORNER RECORDATION CERTIFICATE
 Filing Requirement of Act 74, Mich. P.A. 1970

BERNICE TRETHERWAY
 REGISTER OF DEEDS
 BERRIEN COUNTY, MICHIGAN

Charles W. Barger
 9-10-98

For corners in	Located In:	Corner Code #
1. Public Land Survey	T <u>7S</u> R <u>17W</u>	<u>M11</u>
	T _____ R _____	_____
	T _____ R _____	_____
	T _____ R _____	_____
2. Property Controlling in Section	S _____ T _____ R _____	_____
	S _____ T _____ R _____	_____
3. Miscellaneous Property in Sec.	S _____ T _____ R _____	_____
	S _____ T _____ R _____	_____
4. Lot No. _____, Recorded Plat _____		
5. Private Claims _____		

10/27/98 111#4091 A44
 CORNER \$9.00
 10/27/98 111#4091 A44
 Register of Deeds State & County Number \$2.00

I, Charles W. Barger, in a field survey on July, 19 98, do hereby certify that under requirements of P.A. 74, Michigan P.A. of 1970, the corner points mentioned in lines 1 and 2 above were in conformance with regulations and rules therefore as required in the current manual of survey instructions of the United States Department of the Interior, Bureau of Land Management or by a decree of a Court of Law and/or that the corner points mentioned in lines 3, 4 and 5 above were in conformance with the rules of the Michigan Board of Land Surveyors or by a Decree of a Court of Law; established, re-established, monumented, re-monumented, recovered, found as expressed below:

	A	B	C	D	E	F	G	H	I	J	K	L	M
2	6	5	4	3	2	1							
3													
4	7	8	9	10	11	12							
5													
6	18	17	16	15	14	13							
7													
8	19	20	21	22	23	24							
9													
10	30	29	28	27	26	25							
11													
12	31	32	33	34	35	36							
13													

NOTE: Not more than 4 corners, all in the same town and range, may be recorded on this certificate.


A. Description of original monument and accessories and/or subsequent restoration:
 W. Brookfield 1827 Set corner to Secs 25 & 36 (Also 30 & 31 T7S, R16W) Hickory 14 S40W 15 Uo 14 N46W 39'

B. Description of corner evidence found and/or method applied in restoring or reestablishing corner:
 C. Barger Found Iron w/Cap in Mon Box July 1998 SW Cor Metal Sign Pst N8dE 53.63' Cen of H2O Meter Box S10d29'E 56.82' Wit Tag in Power Pole S5d07'W 47.1' Cen of H2O Meter Box S9d55'W 54.68'

SURVEY & REMONUMENTATION
 NOV 20 1998
 SECTION

C. Description of monument for corner and accessories established to perpetuate locating the position of the corner:
 M11 - 1" pipe 36" long with 2 1/2" Remonumentation Brass Cap in Monument Box SW Cor Metal Sign Pst N8dE 53.63' Cen of H2O Meter Box S10d29'E 56.82' Wit Tag in Power Pole S5d07'W 47.1' Cen of H2O Meter Box S9d55'W 54.68'

And is accepted as a careful and faithful perpetuation of the original corner.

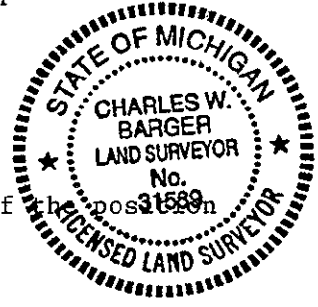

Signed by Charles W. Barger Date October 6, 1998
 Surveyor's Michigan License No. 31589

BERRIEN COUNTY REMONUMENTATION
1998-02-0338

SOUTHEAST QUARTER CORNER SECTION 25, TOWNSHIP 7 SOUTH, RANGE 17 WEST
T7S, R17W, M-11

W. Brookfield
1827

Set corner to Sec 25 & 36
(Also 30 & 31 T7S, R16W)
Hickory 14 S40W 15
Uo 14 N46W 39

L2, P 279
1923

Hole drilled in top of 1'-2' Flint Boulder
about 12" below surface of gravel
19" Black Walnut N12dE 33.9'
21" Hickory N77dE 110.7'
24" Pine S78dE 166.8'

L2, P 279
1926

Set Monument Box
22" Walnut N12d30'E 33.5'
20" Walnut N49d30'E 50.6'
4" Cherry S22dW 50.8'

R. Prestine
1971

Iron in Monument Box
Center of Walnut N8dE 34.4'
Iron N 50'
Iron N 48.7'

D. Rahilly
1978

Found Stone w/Hole Drilled in top 1.5'
below surface of bit core
Set 5/8" Copper clad rod in Mon Box over
Stone w/Hole
Property Iron N 50'
24" Walnut N15dE 34.02'
24" Walnut N50dE 51.57'
Power Pole S05dW 47.14'

C. Barger
July 1998

Found Iron w/Cap in Mon Box
SW Cor Metal Sign Pst N8dE 53.63'
Cen of H2O Meter Box S10d29'E 56.82'
Wit Tag in Power Pole S5d07'W 47.1'
Cen of H2O Meter Box S9d55'W 54.68'

98389.05

SURVEY &
REMONUMENTATION

NOV 20 1998

SECTION