

Berrien County Remonumentation
LAND CORNER RECORDATION CERTIFICATE
 Filing Requirement of Act 74, Mich. P.A. 1970

98 OCT 27 PM 1:06

BERNICE TRETHERWAY
 REGISTER OF DEEDS
 BERRIEN COUNTY, MICHIGAN

For corners in

Berrien

(County)

Located In:

Corner Code ##

- | | | | | | | |
|---------------------------------------|---|-----------|---|------------|-------------|-------|
| 1. Public Land Survey | T | <u>7S</u> | R | <u>17W</u> | <u>M-12</u> | |
| | T | _____ | R | _____ | _____ | |
| | T | _____ | R | _____ | _____ | |
| | T | _____ | R | _____ | _____ | |
| 2. Property Controlling in Section | S | _____ | T | _____ | R | _____ |
| | S | _____ | T | _____ | R | _____ |
| 3. Miscellaneous Property in Sec. | S | _____ | T | _____ | R | _____ |
| | S | _____ | T | _____ | R | _____ |
| 4. Lot No. _____, Recorded Plat _____ | | | | | | |
| 5. Private Claims _____ | | | | | | |

10/27/98 111#4091 A44
 Register of Deeds Stamp & File Number \$9.00
 10/27/98 111#4091 A44
 STATE REMON FEE \$2.00

	A	B	C	D	E	F	G	H	I	J	K	L	M
2	6	5	4	3	2	1							
3													
4	7	8	9	10	11	12							
5													
6	16	17	18	15	14	13							
7													
8	19	20	21	22	23	24							
9													
10	30	29	28	27	26	25							
11													
12	31	32	33	34	35	36							
13													

I, Charles W. Barger, in a field survey on July, 1998, do hereby certify that under requirements of P.A. 74, Michigan P.A. of 1970, the corner points mentioned in lines 1 and 2 above were in conformance with regulations and rules therefore as required in the current manual of survey instructions of the United States Department of the Interior, Bureau of Land Management or by a decree of a Court of Law and/or that the corner points mentioned in lines 3, 4 and 5 above were in conformance with the rules of the Michigan Board of Land Surveyors or by a Decree of a Court of Law; established, re-established, monumented, re-monumented, recovered, found as expressed below:

NOTE: Not more than 4 corners, all in the same town and range, may be recorded on this certificate.

A. Description of original monument and accessories and/or subsequent restoration:

W. Brookfield Set 1/2 Mile Post
 1827 W Oak 6 N89W 3
 Y Ur 12 S 41-1/4W 10


SURVEY & REMONUMENTATION

NOV 20 1998

SECTION

B. Description of corner evidence found and/or method applied in restoring or reestablishing corner:

C. Barger Found Stone w/X Chiseled on top
 July 1988 40" W. Oak N12dE 19.05'
 Power Pole N52d30'W 14.92'
 39" Twin Black Cherry S11dW 8.82'
 36" Black Oak S49dE 30.83'

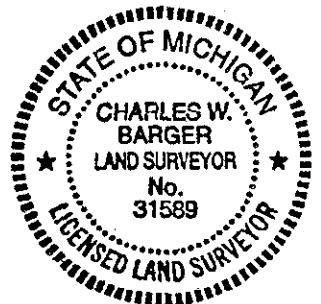

C. Description of monument for corner and accessories established to perpetuate locating the position of the corner:

M12 - 1" pipe 12" long with 2 1/2" Remonumentation Brass Cap in Monument Box over Stone w/X chiseled on top
 Set Witness Tag in W. Oak 3.6'dia N12dE 19.05'
 Set Witness Tag in PP set over PK nail N52d30'W 14.92'
 Set witness Tag in Twin Black Cherry 3.5' dia S11dW
 Set Witness Tag in Black Oak 3.0' dia S49dE 30.83'

And is accepted as a careful and faithful perpetuation of the position of the original corner.

Signed by Charles W. Barger Date October 6, 1998
 Surveyor's Michigan License No. 31589

BERRIEN COUNTY REMONUMENTATION
1998-02-0339

EAST QUARTER CORNER SECTION 36, TOWNSHIP 7 SOUTH, RANGE 17 WEST
T7S, R17W, M-12

W. Brookfield
1827

Set 1/2 Mile Post
W Oak 6 N89W 3
Y Ur 12 S 41-1/4W 10

R. Prestine
1981

Found Stone
Unrecorded Survey 7/14/81

R. Prestine
1992

Found Stone
Recorded Survey L1527, P583

C. Barger
July 1998

Found Stone w/X chiseled on top
40" W. Oak N12dE 19.05'
Power Pole N52d30'W 14.92'
39" Twin Black Cherry S11dW 8.82'
36" Black Oak S49dE 30.83'

SURVEY &
REMONUMENTATION

NOV 20 1998

98389.06

SECTION