

# SURVEY & REMONUMENTATION

APR 26 1995

RAFFIRED BY THE BERRIEN COUNTY  
SURVEY PEER GROUP AS THE  
OFFICIAL CORNER UNDER MICHIGAN  
PUBLIC ACT 345 OF 1990

## COMMISSION Berrien County Remonumentation LAND CORNER RECORDATION CERTIFICATE

Filing Requirement of Act 74, Mich. P.A. 1970

*Charles W. Barger*  
November 29, 1994

For corners in

Berrien (County)	Located In:	Corner Code #
1. Public Land Survey	T <u>7</u> R <u>18</u>	<u>A-1</u>
	T _____ R _____	_____
	T _____ R _____	_____
	T _____ R _____	_____
2. Property Controlling in Section	S _____ T _____ R _____	_____
	S _____ T _____ R _____	_____
3. Miscellaneous Property in Sec.	S _____ T _____ R _____	_____
	S _____ T _____ R _____	_____

RECORDED  
DEC 16 4 02 PM '94  
REGISTER OF DEEDS  
BERRIEN COUNTY MICHIGAN  
Register of Deeds Stamp & File Number

4. Lot No. \_\_\_\_\_, Recorded Plat \_\_\_\_\_  
5. Private Claims \_\_\_\_\_

I, Charles W. Barger, in a field survey on November, 19 94, do hereby certify that under requirements of P.A. 74, Michigan P.A. of 1970, the corner points mentioned in lines 1 and 2 above were in conformance with regulations and rules therefore as required in the current manual of survey instructions of the United States Department of the Interior, Bureau of Land Management or by a decree of a Court of Law and/or that the corner points mentioned in lines 3, 4 and 5 above were in conformance with the rules of the Michigan Board of Land Surveyors or by a Decree of a Court of Law; established, re-established, monumented, re-monumented, recovered, found as expressed below:

	A	B	C	D	E	F	G	H	I	J	K	L	M
2	6		5		4		3		2		1		
3													
4	7		8		9		10		11		12		
5													
6	18		17		16		15		14		13		
7													
8	19		20		21		22		23		24		
9													
10	30		29		28		27		26		25		
11													
12	31		32		33		34		35		36		
13													

**NOTE: Not more than 4 corners, all in the same town and range, may be recorded on this certificate.**

A. Description of original monument and accessories and/or subsequent restoration:

July 1828 - William Brookfield Set frost corner to Townships 6 & 7 South, Ranges 18 & 19 West.

Lynn 20 S. 75 E. 37

12/16/94

111#9004  
CORNER

A&G  
\$9.00

Sugar 20 N. 10 1/2 E. 60


12/16/94

111#9004

A&G  
STATE REMON FEE \$2.00

B. Description of corner evidence found and/or method applied in restoring or reestablishing corner:

A-1 Found 3/4" Iron rod  
Found 3/4" Iron Pipe West 33.0 (1.3' deep)

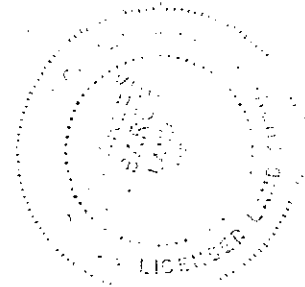

C. Description of monument for corner and accessories established to perpetuate locating the position of the corner:

A-1 Set 1" pipe 2' long in Monument Box w/Brass Remonumentation Cap (2 1/2")  
Set Nail & Witness Tag in Base of Cherry Tree S.89°W., 62.4'  
Set Nail & Witness Tag in PP by Telephone Riser S.57E., 52.5'  
Set Nail & Witness Tag in Telephone Buried Cable Post (4x4)  
N.21E., 70.0'  
Found 3/4" Iron Pipe West 33.0 (1.3' deep)

And is accepted as a careful and faithful perpetuation of the position of the original corner.

Signed by Charles W. Barger P.S.

Date December 16, 1994

Surveyor's Michigan License No. 31589

EAST SOUTHEAST CORNER - SECTION 36-6-19  
NORTH EAST CORNER - SECTION 1-7-1  
SOUTHWEST CORNER - SECTION 31-6-18  
NORTHWEST CORNER - SECTION 6-7-18 (A-1)

01

JULY. 1828

William Brookfield L2. P3 Government Notes

80.00 Set frost corner to Townships 6 & 7 South. Ranges 18  
& 19 West

Lynn 20 S. 75 E. 37  
Sugar 20 N. 10 1/2 E. 60

1829

Lucius Lyon L2. P62 Government Notes

80.00 Set frost corner to Townships 6 & 7 South. Ranges 18  
& 19 West

Lynn 20 S. 75 E. 37  
Sugar 20 N. 10 1/2 E. 60

Circa 1945

Berrien County Road Commission

R.R. Spike  
Cor. Grape Post SE 35.4'  
Iron Pipe & Fence West 33' on line  
Cor. Cherry SE 46.3'  
Cherry Row East is South 34.0'  
Cherry Row South is East 31.5'  
Cor. Headwall SE 24.4'  
Cor. Headwall NE 29.6'

Feb. 1951

H.L. Dreher

R.R. Spike

JAN. 1983

J. Kamer L. 1181. P. 1260 Recorded Survey

Found 3/4" Iron  
PK in Cor. Fence Post S. 88 W. 24.32'  
PK in Tele. Buried Cable Post S. 40 E. 64.35  
PK in Guard Post N. 20 W. 65.79'

NOV. 1994

C.W. Rardner

Found 3/4" Iron Rod  
Set Nail & Witness Tag in base of Cherry Tree S. 29 W. 62.4'  
Set Nail & Witness Tag in PP by Tele. Riser S. 57 E. 52.6  
Set Nail & Witness Tag in Tele. Buried Cable Post (4x4)  
N. 21 E. 70.0'  
Found 3/4" Iron Pipe West 33.0 (1.3' deep)