


RECORDED BY THE BERRIEN COUNTY SURVEY PEER GROUP AS THE OFFICIAL CORNER UNDER MICHIGAN PUBLIC ACT 345 OF 1990
Charles W. Barger
 6-22-95

Berrien County Remonumentation
LAND CORNER RECORDATION CERTIFICATE
 Filing Requirement of Act 74, Mich. P.A. 1970

RECORDED
 SEP 29 11 06 AM '95

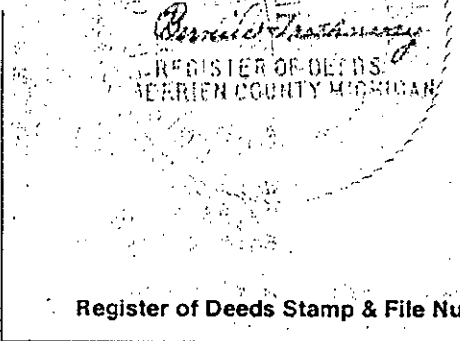

For corners in Berrien (County) Located In: Corner Code # A-9

1. Public Land Survey	T	<u>7S</u>	R	<u>18W</u>	
Comment: T.7S, R.18W, M-9	T		R		
	T		R		
	T		R		
2. Property Controlling in Section	S		T		R
	S		T		R
3. Miscellaneous Property in Sec.	S		T		R
	S		T		R

4. Lot No. _____, Recorded Plat _____
 5. Private Claims _____

I, Charles W. Barger, in a field survey on August, 19 95, do hereby certify that under requirements of P.A. 74, Michigan P.A. of 1970, the corner points mentioned in lines 1 and 2 above were in conformance with regulations and rules therefore as required in the current manual of survey instructions of the United States Department of the Interior, Bureau of Land Management or by a decree of a Court of Law and/or that the corner points mentioned in lines 3, 4 and 5 above were in conformance with the rules of the Michigan Board of Land Surveyors or by a Decree of a Court of Law; established, re-established, monumented, re-monumented, recovered, found as expressed below:

NOTE: Not more than 4 corners, all in the same town and range, may be recorded on this certificate.

A. Description of original monument and accessories and/or subsequent restoration:

1829 - L. Lyon L.2, P.64 Government Notes
 South on East boundary of Sec 24 T7S R19W
 80.00 Set frost corner to Secs 24 & 25
 Beech 10 N26 1/W 34
 Do 20 S75W 16

09/29/95 111#7821 A77
 CORNER \$9.00
 09/29/95 111#7821 A77
 STATE REMAIN FEE \$2.00

B. Description of corner evidence found and/or method applied in restoring or reestablishing corner:


May 1995 - C. Barger
 1/4" Iron Rod in Monument Box
 Found PK on tree N24°W 82.2'
 Found PK on PP #B539-65 N 62°W 99.7'
 Found PK on PP #B564-12 S 64°W 105.9'
 Center of Tele. Ped. S15° E 72.6'

REMONUMENTATION
 MAR 27 1996
 COMMISSION

C. Description of monument for corner and accessories established to perpetuate locating the position of the corner:

A-9 - 1" Pipe 36" long with 2 1/2" Remonumentation Brass Cap in Monument Box
 PK on tree N 24°W 82.2'
 PK on PP #B539-65 N 62°W 99.7'
 PK on PP #B564-12 S 64°W 105.9'
 Center of Telephone Ped. S 15°E 72.6'

And is accepted as a careful and faithful Perpetuation of the position of the original corner.

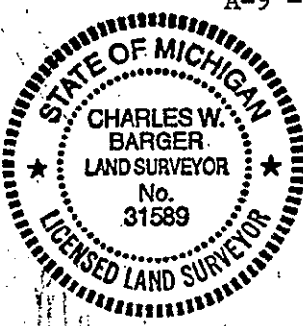

Signed by Charles W. Barger Date September 28, 1995
 Surveyor's Michigan License No. 31589

NORTHWEST CORNER SECTION 30-7-18
SOUTHWEST CORNER SECTION 19-7-18
95512.02

(Buchanan Township - Boyle Lake & Warren Woods Rd)

- 1829 L. Lyon L. 2, P. 64 Government Notes
South on East boundary of Sec. 24 T7S R19W
80.00 Set frost corner to Secs. 24 & 25
Beech 10 N26 1/2W 34
Do 20 S75W 16
- Nov. 1829 W. Brookfield L. 2, PP. 66-67 Government Notes
West on random between Secs. 19 & 30
79.93 W. Boundary 5 N of frost
East corrected between Secs 19 & 30
- May, 1963 H.L. Dreher
Monument
- Mar. 1971 H.L. Dreher L. 893, P. 962 Recorded Survey
Found Monument Box
SE Corner of headwall NW 58.0'
SW corner of headwall NE 55.4'
Center of 16" CMP SE 35.4'
- UNKNOWN R. Prestine
Iron Pipe in Mon. Box
Center of St. Sign N. 25°W. 57.45'
West edge Stop Sign S. 20°E. 35.75'
P.K. in E. Pole S. 60°W. 106.3'
P.K. in 8" Oak S. 50°E. 83.6'
- Mar. 1979 M. Rushlow
Mon. Box, 1/4" Iron Rod
PP S 60°W 106.07'
PP N 60°W 99.56'
Tele. Pole S 30°E 72.43'
- Dec. 1979 R. Harner
Found Iron in Monument
Tel. Riser S 30°E 72.5'
Power Pole S 50°W 106.2'
Center of Twin 18" Wild Cherry N 30°W 82.0'
- Apr. 1994 C. Barger
1/4" Iron Rod in Monument Box
Found PK on tree N 24°W 82.2'
Set PK on PP #B539-65 N 62°W 99.72'
Found PK on PP #B564-12 S 64°W 105.9'
Center of Tele. Ped. S 15°E 72.6'
- May, 1995 C. Barger
1/4" Iron Rod in Monument Box
Found PK on tree N 24°W 82.2'
Found PK on PP #B539-65 N 62°W 99.7'
Found PK on PP #B564-12 S 64°W 105.9'
Center of Tele. Ped. S 15°E 72.6'