

FILED BY THE BERRIEN COUNTY SURVEY PEER GROUP AS THE FICIAL CORNER UNDER MICHIGAN PUBLIC ACT 345 OF 1990

RECORDED

BERRIEN COUNTY REMONUMENTATION
LAND CORNER RECORDATION CERTIFICATE
 Filing Requirement of Act 74, Mich. P.A. 1970

DEC 26 11 46 AM '96

Charles W. Barger
 10-24-96

Berrien County
 REGISTER OF DEEDS
 BERRIEN COUNTY, MICHIGAN

For corners in BERRIEN (County) Located In: _____ Corner Code # _____

1. Public Land Survey	T <u>7S</u> R <u>18W</u>	<u>E1</u>
	T _____ R _____	_____
	T _____ R _____	_____
	T _____ R _____	_____
2. Property Controlling in Section	S _____ T _____ R _____	_____
	S _____ T _____ R _____	_____
3. Miscellaneous Property in Sec.	S _____ T _____ R _____	_____
	S _____ T _____ R _____	_____
4. Lot No. _____, Recorded Plat _____		
5. Private Claims _____		

12/26/96 111#9871 A99
 CORNER \$9.00
 Register/Deeds Stamp #9871 Number A99
 STATE REMON FEE \$2.00

I, CHARLES W. BARGER, in a field survey on DECEMBER, 19 96, do hereby certify that under requirements of P.A. 74, Michigan P.A. of 1970, the corner points mentioned in lines 1 and 2 above were in conformance with regulations and rules therefore as required in the current manual of survey instructions of the United States Department of the Interior, Bureau of Land Management or by a decree of a Court of Law and/or that the corner points mentioned in lines 3, 4 and 5 above were in conformance with the rules of the Michigan Board of Land Surveyors or by a Decree of a Court of Law; established, re-established, monumented, re-monumented, recovered, found as expressed below:

A	B	C	D	E	F	G	H	I	J	K	L	M
2	6	5	4	3	2	1						
3												
4	7	8	9	10	11	12						
5												
6	16	17	16	15	14	13						
7												
8	19	20	21	22	23	24						
9												
10	30	29	28	27	26	25						
11												
12	31	32	33	34	35	36						
13												

NOTE: Not more than 4 corners, all in the same town and range, may be recorded on this certificate.

A. Description of original monument and accessories and/or subsequent restoration:
 MARCH 1827 NORTH BOUNDARY 106 E. OF POST
 W. BROOKFIELD ELM 8 S48E 21
 ASH 6 N57W 29

B. Description of corner evidence found and/or method applied in restoring or reestablishing corner:
 JULY 1996 FOUND IRON BAR
 C. BARGER IRON PIPE WEST 69.82'
 NAIL IN 30" TREE S40°W 73.7'
 NAIL IN 20" TREE EAST 13.9'
 NAIL IN 12" TREE N15°W 12.6'


SURVEY & REMONUMENTATION

MAY 20 1997

COMMISSION

C. Description of monument for corner and accessories established to perpetuate locating the position of the corner:
 E1 1"PIPE 36"LONG WITH 2½" REMONUMENTATION BRASS CAP IN MONUMENT BOX
 REMONUMENTATION MARKER WEST 69.82'
 WITNESS TAG IN 30" TREE S40°W 73.7'
 WITNESS TAG IN 20" TREE EAST 13.9'
 WITNESS TAG IN 12" TREE N15°W 12.6'

AND IS ACCEPTED AS A CAREFUL AND FAITHFUL PERPETUATION OF THE POSITION OF THE ORIGINAL CORNER.

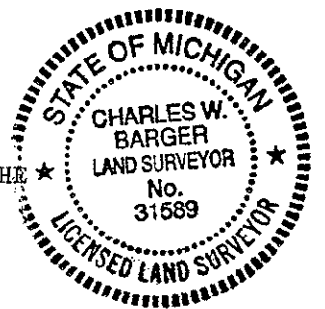

Signed by *Charles W. Barger* Date DECEMBER 19, 1996
 Surveyor's Michigan License No. 31589

BARGER ENGINEERING, INC.
BERRIEN COUNTY REMONUMENTATION

NORTHWEST CORNER SECTION 4, TOWNSHIP 7 SOUTH, RANGE 18 WEST

E1
BURGOYNE ROAD

MARCH 1827 W. BROOKFIELD	NORTH BOUNDARY 106 E OF POST ELM 8 S48E 21 ASH 6 S57W 29
JANUARY 1960 D. DREHER	SURVEY SW CORNER SECTION 33, T6S, R18W CORNER SHOWN, NOT RECORDED
OCTOBER 1974 ER STEPHAN	RECORDED CORNER E-1 FOUND IRON PIPE IRON PIPE WEST 69.82' NAIL IN 18" SYCAMORE S40°W 74.38' NAIL IN 14" TREE EAST 14.55'
JULY 1996 C. BARGER	FOUND IRON BAR IRON PIPE WEST 69.82' NAIL IN 30" TREE S40°W 73.7' NAIL IN 20" TREE EAST 13.9' NAIL IN 12" TREE N15°W 12.6'
FEBRUARY 1995 R. PRESTINE	SURVEY NW CORNER SECTION 4, T7S, R18W CORNER SHOWN, NOT RECORDED

SURVEY &
REMONUMENTATION

MAY 20 1997

COMMISSION