

RATIFIED BY THE BERRIEN COUNTY SURVEY PEER GROUP AS THE OFFICIAL CORNER UNDER MICHIGAN PUBLIC ACT 345 OF 1990

BERRIEN COUNTY REMONUMENTATION LAND CORNER RECORDATION CERTIFICATE Filing Requirement of Act 74, Mich. P.A. 1970

97 NOV 17 PM 2:05 BERRIEN COUNTY, MICHIGAN REGISTER OF DEEDS

RECORDED

For corners in Berrien County Located in: Corner Code #

- 1. Public Land Survey T 8S R 18W E-1 T 7S R 18W E-13 (common)
2. Property Controlling in Section S T R
3. Miscellaneous Property in Sec. S T R
4. Lot No Recorded Plat
5. Private Claims

Register of Deeds Stamp & File Number. Includes dates 11/17/97, file numbers 111#3739, and fees A99 and \$2.00.

I, Alan Bartlett in a field survey on Nov. 7 1997 hereby certify that under requirements of P.A. 74, Michigan P.A. of 1970, the corner points mentioned in lines 1 and 2 above were in conformance with regulations and rules...

Grid table with columns A-M and rows 1-13. A dot is marked at the intersection of column D and row 2.

NOTE: Not more than 4 corners, all in the same town and range, may be recorded on this certificate.

SURVEY & REMONUMENTATION MAR 06 1998 SECTION

A. Description of original monument and accessories and/or subsequent restoration:

(PLEASE SEE BACK OF PAGE)

B. Description of corner evidence found and/or method applied in restoring or reestablishing corner:

- (1) Found State Cap in Monument Box @ Center Line of E/W Road and 3' E of N/S Road.. Verified corner location using existing witnesses.
(2) Historical usage, documentation, and evidence of corner location reviewed and ratified by the BCRP PeerGroup. October 23rd 1997.


C. Description of monument for corner and accessories established to perpetuate locating the position of the corner:

Replaced found State of Michigan Brass Cap and 1"x18" Pipe with Berrien County Remonumentation Cap (stamped 1997 RLS# 35988) and 1" x 36" Pipe placed in Monument Box @ Centerline of E/W Road and 3' East of N/S Gravel Road.

- Witnesses
Found PK Nail in SE face of Power Pole N45°E 40.51'
Found PK Nail in face of Fence Post S3°E 32.74'
Found PK Nail in SE face of Power Pole S45°W 49.00'
Brick House Foundation #1633 N45°W 73.45'

Corner is accepted by a careful and faithful perpetuation of the position of the original corner.

Signed by Alan Bartlett Date 11/13/97 Surveyor's Michigan License No. 35988

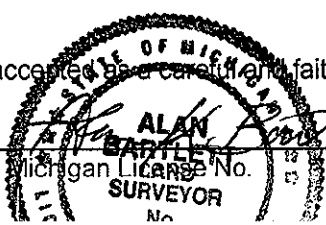

E-1 T8S,R18W Bertrand Twp.
E-13 T7S,R18W Buchanan Twp.

GLO Robert Clark Jr. Nov. 15 1835
80.00 Set Post Corner to Sec 32 and 33 T7S,R18W

Witnesses
W. Oak 24 N43° 53 lks
do 22 N30°E 75 lks

BCRC

RR Spike

Witnesses
NW 73.4' SE Corner House Foundation
S. 24.6' Fence Corner
SW 47.6' T.P.
SW 96.1' NE Corner of Chimney
NE 48.6' T.P.
SE 34.8' Guy Pole
NE 39.8' Elec. Pole
NE 38.5' Fence Post

Sept. 1977 Ron Harner Survey
Found Brass Marker in Monument Box.

Witnesses
N45°W S.E. Corner of House 73.4'
S50°W Power Pole 49.0'
N50°E Power Pole 40.4'

May 1983 John Kamer RLS#27449 Recorded Survey, May 17, 1983 Liber 1181, Page 1268
Standard Marker in Monument Box.

Witnesses
P.K. Nail in P.P. N68°E 40.48'
P.K. Nail in F. Post South 32.38'
P.K. Nail in P.P. S45°W 49.04'

Oct. 1997 Alan Bartlett RLS# 35988 (Landmark Technologies)
Found State Cap in Monument Box @ Center Line of E/W Road and 3' East of N/S Road.

Witnesses
N45°E 40.51' Found P.K. Nail in S.E. Power Pole
S3°E 32.74' Found P.K. Nail in Face of Fence Post
S45°W 49.00' Found P.K. Nail in S.E. Face of Power Pole
N45°W 73.45' Brick House Foundation # 1633

SURVEY &
REMONUMENTATION

MAR 06 1998

SECTION