

RAVISED BY THE _____ N COUNTY
 SURVEY PEER GROUP AS THE
 OFFICIAL CORNER UNDER MICHIGAN
 PUBLIC ACT 345 OF 1990

09/02/94

111#2445 A33
 CORNER \$9.00
 111#2445 A33
 STATE REMON FEE \$2.00

BERRIEN COUNTY REMONUMENTATION
 LAND CORNER RECORDATION CERTIFICATE
 Filing Requirement of Act 74, Mich. P.A. 1970

For corners in

Berrien (County)	Located In:	Corner Code ##
1. Public Land Survey	T <u>7S</u> R <u>19W</u>	F-5
	T _____ R _____	_____
	T _____ R _____	_____
	T _____ R _____	_____
2. Property Controlling in Section	S _____ T _____ R _____	_____
	S _____ T _____ R _____	_____
3. Miscellaneous Property in Sec.	S _____ T _____ R _____	_____
	S _____ T _____ R _____	_____

Register of Deeds
 REGISTER OF DEEDS
 BERRIEN COUNTY MICHIGAN
Barbara J. Stokerson

SEP 2 4 21 PM '94

RECORDED

Register of Deeds Stamp & File Number

4. Lot No. _____, Recorded Plat _____
 5. Private Claims _____

I, John G. Kamer, in a field survey on August 26, 19 94,
 do hereby certify that under requirements of P.A. 74, Michigan P.A. of 1970, the corner points mentioned
 in lines 1 and 2 above were in conformance with regulations and rules therefore as required in the
 current manual of survey instructions of the United States Department of the Interior, Bureau of Land
 Management or by a decree of a Court of Law and/or that the corner points mentioned in lines 3, 4 and 5
 above were in conformance with the rules of the Michigan Board of Land Surveyors or by a Decree of a
 Court of Law; established, re-established, monumented, re-monumented, recovered, found as
 expressed below:

**NOTE: Not more than 4 corners, all in the same town and range, may be recorded
 on this certificate.**

A. Description of original monument and accessories and/or subsequent restoration:

See back.

SURVEY &
 REMONUMENTATION

NOV 07 1994

COMMISSION

	A	B	C	D	E	F	G	H	I	J	K	L	M
2	6	5	4	3	2	1							
3													
4	7	8	9	10	11	12							
5													
6	18	17	16	15	14	13							
7													
8	19	20	21	22	23	24							
9													
10	30	29	28	27	26	25							
11													
12	31	32	33	34	35	36							
13													


B. Description of corner evidence found and/or method applied in restoring or reestablishing corner:

Found 1/2" rebar and cap #27449 distances to adjacent corners were reasonable and consistent.
 April 27, 1994 No evidence of the corner was found by myself.
 I reset the corner per 1973 Dreher Survey and found irons.

C. Description of monument for corner and accessories established to perpetuate locating the position of the corner:

- F-5 Set conc. monument w/brass cap
- Removed 1/2" rebar w/cap #27449
- Set 8 Penny nail w/tag in 15" Elm N37°W 6.59'
- Set 8 Penny nail w/tag in 15" Oak N82°W 39.33'
- Set 8 Penny nail w/tag in 13" Twin Oak S40°E 15.44'
- Set 8 Penny nail w/tag in 8" Maple S49°W 15.01'

Signed by *John G. Kamer*
 Surveyor's Michigan License No. 27449

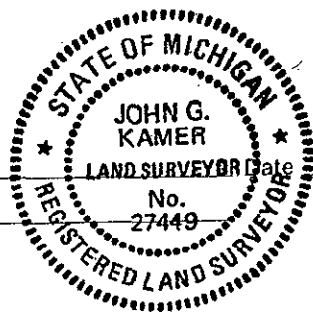

9-01-94

1830

Lucius Lyon
40.08 5 Inch Ash Corner Tree
Com to Secs 9 & 16-7-18

March 22 & 23, 1910

W. J. Cleary - Section Survey
Pipe
1322' & 1322' West
1324' & 1324' East

June 27, 1973

D. M. Dreher - NW 1/4 Section Survey - Lb. 956 pg. 235
1323.16 & 1323.16 West
661.14' N. to a Survey Line

April 27, 1993

Harner - Peirce & Assoc.
1323.29 & 1323.29 E
661.09 N. to a Survey Line

April 26, 1994

J. G. Kamer
No Corner or Evidence of Cor. Found
Reset per 1973 Dreher Survey and Irons.
Set 1/2" Rebar w/Cap
Edge Ditch North 2.5'
PK in 15" Oak N 20° W 6.58'
PK in 15" Oak West 39.33'
PK in 8" Maple S 50° W 15.00'
PK in 13" Twin Oak S 40° E 15.46'



SURVEY &
REMONUMENTATION

NOV 07 1994

COMMISSION

LIBER

3 PAGE 156