

H-11

BERRIEN CO.
T9S R20W










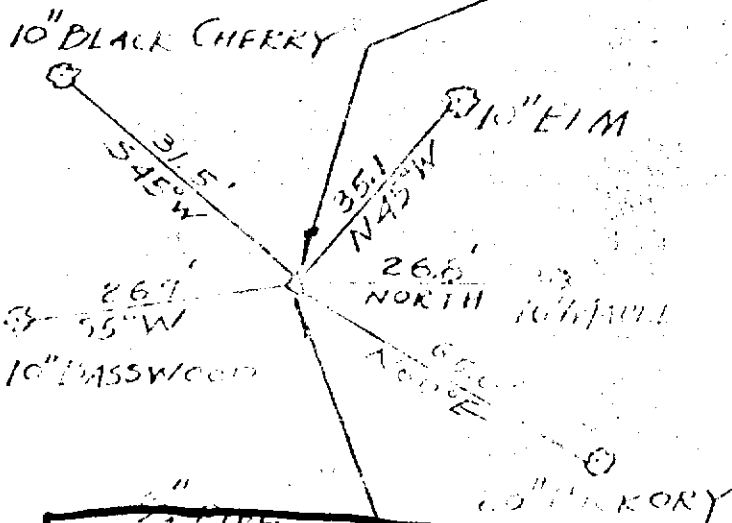

3/4\"/>

33'

3/4\"/>

APPROX 2\"/>

H-11