

RECORDED BY THE BERRIEN COUNTY SURVEY PEER GROUP AS THE OFFICIAL CORNER UNDER MICHIGAN PUBLIC ACT 345 OF 1990

Charles W. Barger
 NOV 20 1994
 For corners in

Berrien County Remonumentation
LAND CORNER RECORDATION CERTIFICATE
 Filing Requirement of Act 74, Mich. P.A. 1970

REGISTER OF DEEDS
 BERRIEN COUNTY MICHIGAN
Charles W. Barger

DEC 16 4 02 PM '94

RECORDED

<u>Berrien</u> (County)	Located In:	Corner Code #
1. Public Land Survey	T <u>8</u> R <u>19</u>	<u>A-1</u>
Comments: T75, R19W, A13	T _____ R _____	_____
<u>T75, R20W, M13</u>	T _____ R _____	<u>M-13</u>
<u>T85, R20W, M1</u>	T _____ R _____	_____
2. Property Controlling in Section	S _____ T _____ R _____	_____
3. Miscellaneous Property in Sec.	S _____ T _____ R _____	_____
4. Lot No. _____, Recorded Plat _____		
5. Private Claims _____		

Register of Deeds Stamp & File Number

A	B	C	D	E	F	G	H	I	J	K	L	M
2	6	5	4	3	2	1						
3												
4	7	8	9	10	11	12						
5												
6	13	17	16	15	14	13						
7												
8	19	20	21	22	23	24						
9												
10	30	29	28	27	26	25						
11												
12	31	32	33	34	35	36						
13												

I, Charles W. Barger, in a field survey on November, 19 94, do hereby certify that under requirements of P.A. 74, Michigan P.A. of 1970, the corner points mentioned in lines 1 and 2 above were in conformance with regulations and rules therefore as required in the current manual of survey instructions of the United States Department of the Interior, Bureau of Land Management or by a decree of a Court of Law and/or that the corner points mentioned in lines 3, 4 and 5 above were in conformance with the rules of the Michigan Board of Land Surveyors or by a Decree of a Court of Law; established, re-established, monumented, re-monumented, recovered, found as expressed below:

NOTE: Not more than 4 corners, all in the same town and range, may be recorded on this certificate.


A. Description of original monument and accessories and/or subsequent restoration:

July, 1829 - Lucius Lyons
 80.00 Set post corner to Townships 7 & 8 South, Ranges 19 & 20 West
 12/16/94 111#9004 A66
 CORNER \$9.00
 Beech 8 S. 36 W. 39 12/16/94 111#9004 A66
 Svc. 24 N. 61 W. 36 STATE REMON FEE \$2.00

B. Description of corner evidence found and/or method applied in restoring or reestablishing corner:

A-1 Found Plug in Monument Box
 Found PK nail in Power Pole S.45E., 45.0'
 Found PK nail in Power Pole N.31E., 46.0'
 Found PK nail in Power Pole S.40W., 39.2'
 Center of Telephone Box N.44W., 42.2'

Survey & Monumentation
 DEC 17 1995
Commissioner

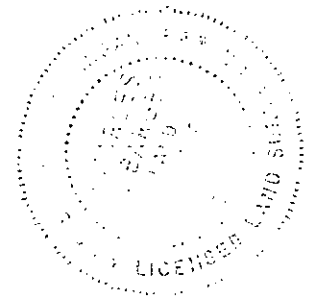

C. Description of monument for corner and accessories established to perpetuate locating the position of the corner:

A-1 1" Pipe set (1' Deep) w/2 1/2" Remonumentation Brass Cap in Monument Box over Stone
 Set Witness Tag in Power Pole S.45E., 45.0'
 Set Witness Tag in Power Pole N.31E., 46.0'
 Set Witness Tag in Power Pole S.40W., 39.2'
 Center of Telephone Box N.44W., 42.2'

And is accepted as a careful and faithful perpetuation of the position of the original corner.

Signed by Charles W. Barger P.S. Date December 16, 1994
 Surveyor's Michigan License No. 31589

