

LAND CORNER RECORDATION CERTIFICATE
Filing Requirement of Act 74, Mich. P.A. 1970
BERRIEN COUNTY REMONUMENTATION

Nov 29 4 38 PM '95

Berrien County
REGISTER OF DEEDS
SEARCH COUNTY, MICHIGAN

Dale Kesler
11-22-95
For corners in

Located In: Berrien (County) Corner Code: A5

1. Public Land Survey	T <u>8</u> S <u>17</u> R <u>W</u>	<u>A5</u>
	T _____ R _____	_____
	T _____ R _____	_____
	T _____ R _____	_____
2. Property Controlling in Section	S _____ T _____ R _____	_____
	S _____ T _____ R _____	_____
3. Miscellaneous Property in Sec.	S _____ T _____ R _____	_____
	S _____ T _____ R _____	_____

11/29/95 11182021 A33
REGISTER OF DEEDS CORNER \$7.00
Register of Deeds Stamp & File Number A33
STATE DEEDS FEE \$2.00

4. Lot No. _____, Recorded Plat _____
5. Private Claims _____

A	B	C	D	E	F	G	H	I	J	K	L	M
2	6	5	4	3	2	1						
3												
4	7	8	9	10	11	12						
5												
6	18	17	16	15	14	13						
7												
8	19	20	21	22	23	24						
9												
10	30	29	28	27	26	25						
11												
12	31	32	33	34	35	36						
13												

I, Dale L. Kesler, in a field survey on November 21, 19 95, do hereby certify that under requirements of P.A. 74, Michigan P.A. of 1970, the corner points mentioned in lines 1 and 2 above were in conformance with regulations and rules therefore as required in the current manual of survey instructions of the United States Department of the Interior, Bureau of Land Management or by a decree of a Court of Law and/or that the corner points mentioned in lines 3, 4 and 5 above were in conformance with the rules of the Michigan Board of Land Surveyors or by a Decree of a Court of Law; established, re-established, monumented, re-monumented, recovered, found as expressed below:

NOTE: Not more than 4 corners, all in the same town and range, may be recorded on this certificate.

A. Description of original monument and accessories and/or subsequent restoration:

December 6, 1835 Government Surveyor, Robert Clark, Jr.; accessories, Intersected West Bound 4.06 chains North of Post Corner to Sections 12 and 13, T 8 S, R 18 W, accessories, 18" Yellow Oak - N. 78 1/4° E. 2.77, 16" Black Oak - S. 52 1/4° E. 2.20: April 13, 1887 - W. Graves, County Surveyor, Stone from Government witnesses standing.


B. Description of corner evidence found and/or method applied in restoring or reestablishing corner:

Found 1/2" bar. Accepted 1/2" bar as best evidence of corner.

Dale Kesler
COMMISSION
MAR 27 1996
COMMISSION

C. Description of monument for corner and accessories established to perpetuate locating the position of the corner:

Set standard 3' long pipe with brass plate in place of found 1/2" bar in monument box and is accepted as a careful and faithful perpetuation of the position of the original corner.
SE corner of one story brick house N 58°15' W 123.27'
Set nail w/witness tag in 36" maple tree S 73°10' E 32.36'
NW corner of two story brick house S 45°02' E 89.73'
Set nail w/witness tag in Power Pole S 12°34' E 107.16'
Found Railroad spike North 324.12'

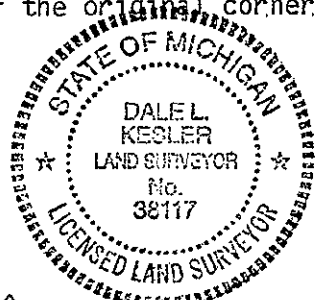

Signed by Dale Kesler Date November 29, 1995
Surveyor's Michigan License No. 38117