

RAISED BY THE BERRIEN COUNTY SURVEY PEER GROUP AS THE OFFICIAL CORNER UNDER MICHIGAN PUBLIC ACT 345 OF 1990

RECORDED

Berrien County Remonumentation
LAND CORNER RECORDATION CERTIFICATE
 Filing Requirement of Act 74, Mich. P.A. 1970

NOV 17 PM 1:38

BERNICE TRETHERWAY
 REGISTER OF DEEDS
 BERRIEN COUNTY, MICHIGAN

For corners in

Berrien
 (County)

Located in: Corner Code #

- | | | | | | |
|------------------------------------|---|----|---|-----|-----|
| 1. Public Land Survey | T | 8S | R | 17W | J-7 |
| | T | | R | | |
| | T | | R | | |
| | T | | R | | |
| 2. Property Controlling in Section | S | | T | | R |
| | S | | T | | R |
| 3. Miscellaneous Property in Sec. | S | | T | | R |
| | S | | T | | R |
- DEC 28 1999
- SECTION
4. Lot No. _____, Recorded Plat _____
5. Private Claims _____

11/17/99 111#8178 A77
 CORNER \$9.00
 11/17/99 111#8178 A77
 Register of Deeds Stamp & File Number
 STATE REMON FEE \$2.00

I, Charles W. Barger, in a field survey on November 5, 19 99, do hereby certify that under requirements of P.A. 74, Michigan P.A. of 1970, the corner points mentioned in lines 1 and 2 above were in conformance with regulations and rules therefore as required in the current manual of survey instructions of the United States Department of the Interior, Bureau of Land Management or by a decree of a Court of Law and/or that the corner points mentioned in lines 3, 4 and 5 above were in conformance with the rules of the Michigan Board of Land Surveyors or by a Decree of a Court of Law; established, re-established, monumented, re-monumented, recovered, found as expressed below:

	A	B	C	D	E	F	G	H	I	J	K	L	M
2	6	5	4	3	2	1							
3													
4	7	8	9	10	11	12							
5													
6	18	17	16	15	14	13							
7													
8	19	20	21	22	23	24							
9													
10	30	29	28	27	26	25							
11													
12	31	32	33	34	35	36							
13													


NOTE: Not more than 4 corners, all in the same town and range, may be recorded on this certificate.

A. Description of original monument and accessories and/or subsequent restoration:

W. Brookfield	Set Quarter Section Post
7/10/1828	Y. Oak 10 S77E 6
	"UO 16 S24-1/2W 28

B. Description of corner evidence found and/or method applied in restoring or reestablishing corner:

C. Barger	Found 1" Capped Iron Pipe in Monument Box
2/24/99	Found PK in PP N25deg29'E 62.72'
	Found PK in PP N81deg34'E 41.19'
	Found PK in PP N80deg54'W 54.21'
	Found PK in PP N21deg56'W 65.06'

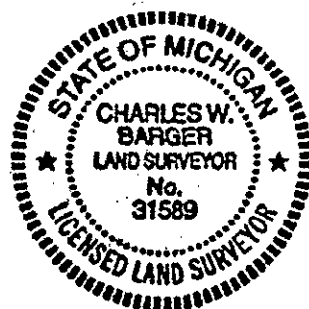

C. Description of monument for corner and accessories established to perpetuate locating the position of the corner:

J-7 1" pipe 36" long with 2 1/2" Remonumentation Brass Cap in Monument Box (Monument Box 31' south of centerline of Ontario Road)
 Center of Sanitary Manhole N20degE 25.56'
 Set Witness Tag in PP N80deg54'W 54.21'
 Center of USGS Marker N30deg06'W 66.6' (1925 - PT STA N021Y)
 Set Witness Tag in PP N25deg29'E 62.72'

And is accepted as a careful and faithful perpetuation of the position of the original corner.

Signed by Charles W. Barger P.S.

Date November 9, 1999

Surveyor's Michigan License No. 31589

SOUTH QUARTER CORNER SECTION 14, TOWNSHIP 8 SOUTH, RANGE 17 WEST
J-7

W. Brookfield
7/10/1828

Set Quarter Section Post
Y. Oak 10 S77E 6
"UO 16 S24-1/2W 28

D.M. Dreher
7/8/71

Found Monument Box
Center of Tele Pole N84degE 41.1'
Center 10" Maple S76degW 41.0'
Center 3" Steel Fence Post S22degE 82.6'

Ron Harner
2/19/73

Found Bolt in Monument Box
Iron East 33'
C/L PP N84degE 41.1'
C/L 10" Maple S76degW 41'
C/L 3" Steel Corner Post S22degE 82.6'

Robt Prestine
6/13/79

1" Iron in Monument Box
Spike in Elect Pole N80degW 54.55'
Nail in Tele Pole N85degE 41'
CTR Sanitary Manhole N20degE 25.5'

Robt Prestine
Barger Engineering
5/29/80

1" Iron in Monument Box
Spike in Elect Pole N80degW 54.55'
Nail in Tele Pole N85degE 41.0'
CTR Sanitary Manhole N20degE 25.5'

Robt Prestine
Barger Engineering
12/5/80

1" Iron in Monument Box
Spike in Elect Pole N80degW 54.55'
Nail in Tele Pole N85degE 41.0'
CTR Sanitary Manhole N20degE 25.5'

Robt Prestine
9/14/87

Iron in Monument Box
Elect Pole N80degW 54.55'
Tele Pole N85degE 41.0'

Robt Prestine
6/9/94

Iron in Monument Box
Spike in Elect Pole N80degW 54.55'
Nail in Tele Pole N85degE 41.0'
CTR Sanitary Manhole N20degE 25.5'

C. Barger
2/24/99

Found 1" Capped Iron Pipe in Monument Box
Found PK in PP N25deg29'E 62.72'
Found PK in PP N81deg34'E 41.19'
Found PK in PP N80deg54'W 54.21'
Found PK in PP N21deg56'W 65.06'
Set PK for Witness 150' North
Set PK for Witness 150' South

**Set Due to
Construction
along Third
Street

Barger Engineering, Inc.
9923904

SURVEY &

DEC 28 1999

SECTION