

SURVEY & REMONUMENTATION
 DEC 08 1993
 COMMISSION

11/29/93 111#2893 A33
 CORNER \$7.00
 11/29/93 111#2893 A33
 STATE REMON FEE \$2.00

LAND CORNER RECORDATION CERTIFICATE
FILING REQUIREMENT OF ACT 74, MICH. P.A.1970

Berrien County Remonumentation

FOR CORNERS OF-- Berrien LOCATED IN--
County

1. PUBLIC LAND SURVEY T. 8 N. S., R. 17 E. W. CORNER CODE NUMBER K-9

2. PROPERTY CONTROLLING IN SECTION 23, T. 8 N. S., R. 17 E. W.

3. MISCELLANEOUS PROPERTY IN SECTION _____, T. _____ N. S., R. _____ E. W.

4. LOT NO. _____, RECORDED PLAT _____

5. PRIVATE CLAIMS _____

RECORDED
 NOV 29 2 09 PM '93
 REGISTER OF DEEDS STAMP AND FILING NUMBER

I, Robert W. Prestine, do hereby certify that under requirements of P.A. 74, Michigan P.A. of 1970, the corner points mentioned in lines 1 and 2 above were, in a field survey on OCT. 29, 1993, established, re-established, monumented, re-monumented, recovered or restored as expressed below and in conformance with regulations and rules therefore as required in the current manual of survey instructions of the United States Department of the Interior, Bureau of Land Management or by a decree of a court of law. Furthermore, that the corner points mentioned in lines 3, 4 and 5 above were, in a field survey on _____, 19____, found, recovered, restored, established or re-established as expressed below and in conformance with the rules of the Michigan State Board of Registration for Land Surveyors or, by a Decree of a Court of law:


A. Description of original monument and accessories and/or subsequent restoration:
 K-9 Set Post, Wm. Brookfield D.S. 1827
 SE. COR. 45.49 Chs. intersected END Line 2.92 Chains
 Sec. 23 East of mile post 30.
 W. OAK 24" N 8° W 25
 " 18" N 51 1/2° E 78

B. Description of corner evidence found and/or method applied in restoring or re-establishing corner:
 K-9 Found 3/4" pinched pipe
 Checked with surveys by other & by WIT'S

C. Description of monument for corner and accessories established to perpetuate locating the position of the corner:
 K-9 removed pinched pipe & set 3/4" x 36" pipe with Berrien County remonumentation cap & set monument box
 Nail & washer in S. side Elec. Pole N 86° E 37.11'
 " " " E side 12' OAK S 13° W 15.83'
 " " " W. Side 10" W. OAK S 33° E 22.57'
 Sw. rim of San. M. H. NE. 32.15'
 & STATE LINE Rd as CONSTRUCTED North 19.5'±
 Ratified by Peer Group 11-8-93

SIGNED BY Robert W. Prestine DATE Nov. 29-93
 SURVEYOR'S MICHIGAN REGISTRATION NO. 18662

FOR STATE AND UNITED STATES AGENCIES:
 SIGNED BY _____ DATE _____
 CHIEF OF SURVEY PARTY
 APPROVED AND SIGNED BY _____ DATE _____
 MICHIGAN REGISTERED LAND SURVEYOR

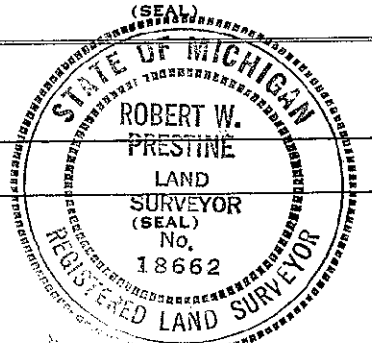

SURVEYOR'S MICHIGAN REGISTRATION NO. _____