

BERRIEN COUNTY REMONUMENTATION

RECORDED

LAND CORNER RECORDATION CERTIFICATE
Filing Requirement of Act 74, Mich. P.A. 1970

DEC 13 10 50 AM '95

For corners in
BERRIEN
(County)

Located In: Corner Code #

- | | | | | | | | |
|------------------------------------|---|---|---|---|----|---|-----|
| 1. Public Land Survey | T | 8 | S | R | 18 | W | A-9 |
| | T | | R | | | | |
| | T | | R | | | | |
| | T | | R | | | | |
| 2. Property Controlling in Section | S | | T | | R | | |
| | S | | T | | R | | |
| 3. Miscellaneous Property in Sec. | S | | T | | R | | |
| | S | | T | | R | | |
4. Lot No. _____, Recorded Plat _____
5. Private Claims _____

Robert W. Prestine
REGISTER OF DEEDS
BERRIEN COUNTY, MICHIGAN

Register of Deeds Stamp & File Number

	A	B	C	D	E	F	G	H	I	J	K	L	M
2	6	5	4	3	2	1							
3													
4	7	8	9	10	11	12							
5													
6	10	17	16	15	14	13							
7													
8	19	20	21	22	23	24							
9													
10	30	29	28	27	26	25							
11													
12	31	32	33	34	35	36							
13													

I, Robert W. Prestine, in a field survey on November 24, 1995, do hereby certify that under requirements of P.A. 74, Michigan P.A. of 1970, the corner points mentioned in lines 1 and 2 above were in conformance with regulations and rules therefore as required in the current manual of survey instructions of the United States Department of the Interior, Bureau of Land Management or by a decree of a Court of Law and/or that the corner points mentioned in lines 3, 4 and 5 above were in conformance with the rules of the Michigan Board of Land Surveyors or by a Decree of a Court of Law; established, re-established, monumented, re-monumented, recovered, found as expressed below:

NOTE: Not more than 4 corners, all in the same town and range, may be recorded on this certificate.

A. Description of original monument and accessories and/or subsequent restoration:

A-9 Southwest corner, Section 19, T. 8 S., R. 18 W.
On Indiana-Michigan State Line
Govt. wits gone
Robert Clark, Jr. D.S.
Beech 24" N 53° E 35
Poplar 16" N 29½° E 65

12/13/95 111#2978 A66
CORNER \$7.00
12/13/95 111#2978 A66
STATE REMON FEE \$2.00

B. Description of corner evidence found and/or method applied in restoring or reestablishing corner:


A-9
Found ½" rebar & stone, as shown on survey by Stefan - Strebbs, November 5, 86, at or near old fence corner.

MAR 27 1996
COMMISSION

C. Description of monument for corner and accessories established to perpetuate locating the position of the corner:

A-9
Set 4" round Berrien County Remonumentation monument
Nail & tag in 22" Walnut N 2° E 19.20'
Nail & tag in 15" Pine S 48° E 26.40'
Nail & tag in 21" Osage S 22° W 28.75'
Nail & tag in 8" Ash S 75° W 9.35'

This position is accepted as a careful and faithful reestablishment of the position of the original corner.

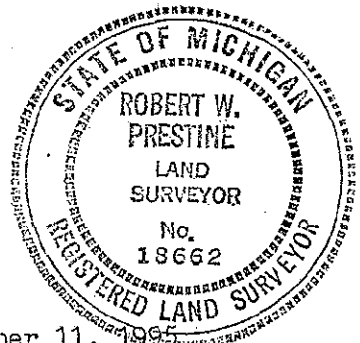

Signed by Robert W. Prestine Date December 11, 1995
Surveyor's Michigan License No. 18662