

RATIFIED BY THE BERRIEN COUNTY SURVEY PEER GROUP AS THE OFFICIAL CORNER UNDER MICHIGAN PUBLIC ACT 345 OF 1990

RECORDED

BERRIEN COUNTY REMONUMENTATION

LAND CORNER RECORDATION CERTIFICATE
Filing Requirement of Act 74, Mich. P.A. 1970

DEC 13 10 50 AM '95

For corners in

Robert W. Prestine
REGISTER OF DEEDS
BERRIEN COUNTY MICHIGAN

BERRIEN (County)	Located In:	Corner Code #
1. Public Land Survey	T 8 S R 18 W	D-9
	T _____ R _____	_____
	T _____ R _____	_____
	T _____ R _____	_____
2. Property Controlling in Section	S _____ T _____ R _____	_____
	S _____ T _____ R _____	_____
3. Miscellaneous Property in Sec.	S _____ T _____ R _____	_____
	S _____ T _____ R _____	_____
4. Lot No. _____, Recorded Plat _____		
5. Private Claims _____		

Register of Deeds Stamp & File Number

I, Robert W. Prestine, in a field survey on November 24, 19 95, do hereby certify that under requirements of P.A. 74, Michigan P.A. of 1970, the corner points mentioned in lines 1 and 2 above were in conformance with regulations and rules therefore as required in the current manual of survey instructions of the United States Department of the Interior, Bureau of Land Management or by a decree of a Court of Law and/or that the corner points mentioned in lines 3, 4 and 5 above were in conformance with the rules of the Michigan Board of Land Surveyors or by a Decree of a Court of Law; established, re-established, monumented, re-monumented, recovered, found as expressed below:

A	B	C	D	E	F	G	H	I	J	K	L	M
2	6	5	4	3	2	1						
3												
4	7	8	9	10	11	12						
5												
6	10	17	16	15	14	13						
7												
8	19	20	21	22	23	24						
9												
10	30	29	28	27	26	25						
11												
12	31	32	33	34	35	36						
13												

NOTE: Not more than 4 corners, all in the same town and range, may be recorded on this certificate.


A. Description of original monument and accessories and/or subsequent restoration:
D-9 South Quarter Corner Section 20, T. 8 S., R. 18 W.
This corner not set by Govt.
Unable to find corner or record of corner ever set by others.

12/13/95 111#2978 A66
CORNER \$7.00
12/13/95 111#2978 A66
STATE REMON FEE \$2.00

B. Description of corner evidence found and/or method applied in restoring or reestablishing corner:
D-9
Did not find corner set in line with W.P.A. monuments on State Line as set for Indiana State Line in Section 9, T. 38 N., R. 1 E. (1938). Set half way between SW & SE corner of Section 20.

MAR 27 1996
COMMISSION

C. Description of monument for corner and accessories established to perpetuate locating the position of the corner:
D-9
Set 3/4" x 36" pipe & Remon Cap in monument box in gravel.
SW corner house N 74° E 56.0'
Nail & tag in Elec. Pole S 88° W 52.25'
Angle iron post in conc. South 14.05'
Nail & tag in 12" Maple N 33° E 13.50'
Center asphalt road West 16' ±
1/2" rebar West 21.35', believed to be Indiana corner.

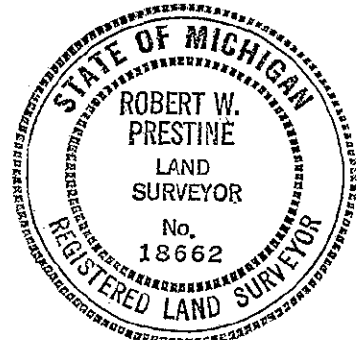

This position is accepted as a careful and faithful reestablishment of the position of the original corner.

Signed by Robert W. Prestine Date December 11, 1995

Surveyor's Michigan License No. 18662