

RATIFIED BY THE BERRIEN COUNTY SURVEY PEER GROUP AS THE OFFICIAL CORNER UNDER MICHIGAN PUBLIC ACT 345 OF 1990

*[Signature]*  
11-09-95

*BERRIEN COUNTY REMONUMENTATION*

**LAND CORNER RECORDATION CERTIFICATE**  
Filing Requirement of Act 74, Mich. P.A. 1970

RECORDED  
Dec 13 10 50 AM '95

*Robert W. Prestine*  
REGISTER OF DEEDS  
BERRIEN COUNTY MICHIGAN

For corners in BERRIEN (County)

Located In: \_\_\_\_\_ Corner Code # \_\_\_\_\_

1. Public Land Survey	T 8 S R 18 W	E-9
	T _____ R _____	_____
	T _____ R _____	_____
	T _____ R _____	_____
2. Property Controlling in Section	S _____ T _____ R _____	_____
	S _____ T _____ R _____	_____
3. Miscellaneous Property in Sec.	S _____ T _____ R _____	_____
	S _____ T _____ R _____	_____

4. Lot No. \_\_\_\_\_, Recorded Plat \_\_\_\_\_

5. Private Claims \_\_\_\_\_

Register of Deeds Stamp & File Number

I, Robert W. Prestine, in a field survey on November 24, 19 95, do hereby certify that under requirements of P.A. 74, Michigan P.A. of 1970, the corner points mentioned in lines 1 and 2 above were in conformance with regulations and rules therefore as required in the current manual of survey instructions of the United States Department of the Interior, Bureau of Land Management or by a decree of a Court of Law and/or that the corner points mentioned in lines 3, 4 and 5 above were in conformance with the rules of the Michigan Board of Land Surveyors or by a Decree of a Court of Law; established, re-established, monumented, re-monumented, recovered, found as expressed below:

	A	B	C	D	E	F	G	H	I	J	K	L	M
2	6	5	4	3	2	1							
3													
4	7	8	9	10	11	12							
5													
6	18	17	16	15	14	13							
7													
8	19	20	21	22	23	24							
9													
10	30	29	28	27	26	25							
11													
12	31	32	33	34	35	36							

**NOTE:** Not more than 4 corners, all in the same town and range, may be recorded on this certificate.

A. Description of original monument and accessories and/or subsequent restoration:  
E-9 Southeast Corner Section 20 T. 8 S., R. 18 W. Govt.  
Burr Oak 18" N 46½ E 66  
Burr Oak 16" N 6½ W 54

12/13/95 111H2978 A66  
CORNER \$7.00  
12/13/95 111H2978 A66  
STATE REMON FEE \$2.00


B. Description of corner evidence found and/or method applied in restoring or reestablishing corner:  
E-9  
Found remains of old post when excavating with backhoe. Believed to be old post. Corner is on line with W.P.A. monuments set for Indiana State Line (1938)  
Area is all heavy & muck type soil.  
½" iron used by others for this corner is in line with center of road to North is N 78° E 18.35'

*[Signature]*  
COMMISSION

MAR 27 1996

C. Description of monument for corner and accessories established to perpetuate locating the position of the corner:  
E-9  
Set 4" round Berrien County Remonumentation monument.  
Nail & tag in Elec. Pole S 48° W 66.94'  
NE corner conc. post S 41° W 74.06'  
SW corner conc post N 87° E 36.07'  
Center road West 35.5' (gravel)

This position is accepted as a careful and faithful reestablishment of the position of the original corner.

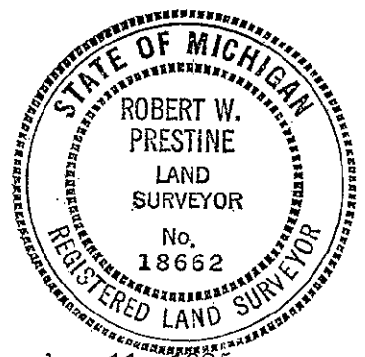

Signed by Robert W. Prestine Date December 11, 1995  
Surveyor's Michigan License No. 18662