

RATIFIED BY THE BERRIEN COUNTY SURVEY PEER GROUP AS THE OFFICIAL CORNER UNDER MICHIGAN PUBLIC ACT 345 OF 1990

RECORDED

LAND CORNER RECORDATION CERTIFICATE
 Filing Requirement of Act 74, Mich. P.A. 1970
 Berrien County Remonumentation

NOV -4 PM 3: 23
 BERNICE TRETHERWAY
 REGISTER OF DEEDS
 BERRIEN COUNTY, MICHIGAN

Sept. 7, 1999
[Signature]
 For corners in

BERRIEN
 (County)

Located In: _____ Corner Code # _____

1. Public Land Survey T 8S R 18W K9
 SW Cor Frac. Sec 24

2. Property Controlling in Section
 S _____ T _____ R _____
 S _____ T _____ R _____

3. Miscellaneous Property in Sec.
 S _____ T _____ R _____
 S _____ T _____ R _____

11/04/99 111#7199 A55
 CORNER \$7.00
 11/04/99 111#7199 A55
 STATE REMON FEE \$2.00
 Register of Deeds Stamp & File Number

4. Lot No. _____, Recorded Plat _____
 5. Private Claims _____

I, DALE L. KESLER, in a field survey on August 27, 1999 do hereby state that under requirements of P.A. 74, Michigan P.A. of 1970, the corner points mentioned in lines 1 and 2 above were in conformance with regulations and rules therefore as required in the current manual of survey instructions of the United States Department of the Interior, Bureau of Land Management or by a decree of a Court of Law and /or that the corner points mentioned in lines 3, 4 and 5 above were in conformance with the rules of the Michigan Board of Land Surveyors or by a Decree of a Court of Law; established, re-established, monumented, recovered, found as expressed below:

1	A	B	C	D	E	F	G	H	I	J	K	L	M
2	6		5		4		3		2		1		
3													
4	7		8		9		10		11		12		
5													
6	18		17		16		15		14		13		
7													
8	19		20		21		22		23		24		
9													
10	30		29		28		27		26		25		
11													
12	31		32		33		34		35		36		
13													

NOTE: Not more than 2 corners, all in the same town and range, may be recorded on this certificate.


A. Description of original monument and accessories and/or subsequent restoration:
 NOVEMBER 1835, ROBERT CLARK. SET POST ON STATE LINE.

APRIL 1972, BOB PRESTINE. FOUND 3/4 IRON PIPE. WITNESSES: C 48" CHERRY N 58 DEGREES 30'W 43.2', C 42" TRIPLE OAK N 88 DEGREES 40' W 61.2', C 30" HICKORY N 45 DEGREES EAST 14.4', FACE R.R. TIE COR. POST EAST 15.4'

FEB. 1974, D. M. DREHER. FOUND IRON

B. Description of corner evidence found and/or method applied in restoring or reestablishing corner:
 FOUND 3/4" IRON PIPE. WITNESSES FROM PRESTINE'S 1972 SURVEY VERIFY CORNER. MEASURED NORTH TO THE NORTHWEST CORNER OF SECTION 24, T8S, R18W COMPARE WITH PRESTINE'S 1972 SURVEY AND DREHER'S 1974 SURVEY. ACCEPTED IRON PIPE AS BEST EVIDENCE OF THE ORIGINAL CORNER.

C. Description of monument for corner and accessories established to perpetuate locating the position of the corner:
 SET 4" X 36" CONCRETE MONUMENT WITH BRASS CAP IN PLACE OF 3/4" IRON PIPE AND IS ACCEPTED AS A CAREFUL AND FAITHFUL PERPETUATION OF THE POSITION OF THE ORIGINAL CORNER.
 SET P.K. NAIL IN WEST SIDE 10" BOX ELDER N 33 DEGREES E 12.14'
 CENTER 4" DIA X 5.0' STEEL POST N 53 DEGREES W 44.85'
 SET P.K. NAIL IN 8" BOXELDER N 80 DEGREES E 13.82'
 SET P.K. NAIL IN FACE 20" TWIN CHERRY S 45 DEGREES W 54.63'

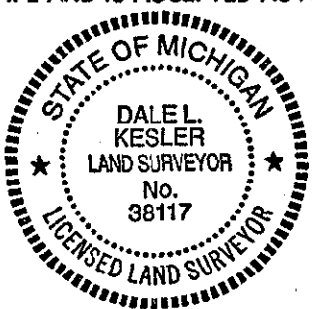

DEC 2 3 1999

SECTION

Signed by *[Signature]*
 Surveyor's Michigan License No. 38117

Date 11/2/99

FORM APPROVED BY MICHIGAN STATE BOARD OF PROFESSIONAL SURVEYORS, JAN. 28, 1971
 REVISED MAY 14, 1975
 REVISED JAN. 1983
 REVISED OCT. 1986