

LAND CORNER RECORDATION CERTIFICATE Nov 29 4 38 PM '95
Filing Requirement of Act 74, Mich. P.A. 1970

BERRIEN COUNTY REMONUMENTATION

Bernie Stenberg
REGISTER OF DEEDS
BERRIEN COUNTY, MICHIGAN

For corners in

Berrien (County)

Located In:

Corner Code ##

1. Public Land Survey	T	8 S	R	18W	M5
	T		R		
	T		R		
	T		R		
2. Property Controlling in Section	S		T	R	
	S		T	R	
3. Miscellaneous Property in Sec.	S		T	R	
	S		T	R	

11/29/95 111R2021 033
CORNER \$7.00
11/29/95 111R2021 033
Register of Deeds Stamp & File Number 2.00

4. Lot No. _____, Recorded Plat _____
5. Private Claims _____

	A	B	C	D	E	F	G	H	I	J	K	L	M
2	6	5	4	3	2	1							
3													
4	7	8	9	10	11	12							
5													
6	10	17	16	15	14	13							
7													
8	19	20	21	22	23	24							
9													
10	30	29	28	27	26	25							
11													
12	31	32	33	34	35	36							
13													

I, Dale L. Kesler, in a field survey on November 21, 1995, do hereby certify that under requirements of P.A. 74, Michigan P.A. of 1970, the corner points mentioned in lines 1 and 2 above were in conformance with regulations and rules therefore as required in the current manual of survey instructions of the United States Department of the Interior, Bureau of Land Management or by a decree of a Court of Law and/or that the corner points mentioned in lines 3, 4 and 5 above were in conformance with the rules of the Michigan Board of Land Surveyors or by a Decree of a Court of Law; established, re-established, monumented, re-monumented, recovered, found as expressed below:

NOTE: Not more than 4 corners, all in the same town and range, may be recorded on this certificate.

A. Description of original monument and accessories and/or subsequent restoration:

November 17, 1835 Government Surveyor, Robert Clark, Jr.; accessories, 12" Oak - S. 74 1/2° W 93 links, 10" Oak - N. 69 1/2° W. 1.26 chains: 1947 James Hampton found corner, measured North 268' to adjacent corner: 1967 Berrien County Road Commission, Found Monument box over iron; accessories, N. End Cemetary iron fence - N. 30° W. 62.70', SE Corner base Swartz Tombstone W. 51.4', NE Corner base Enninger Tombstone SW 64.5'.

B. Description of corner evidence found and/or method applied in restoring or reestablishing corner:


Found standard brass tablet - State of Michigan. Accepted brass tablet as best evidence of corner.

JAMES H. HAMPTON
MAR 27 1996
COMMISSION

C. Description of monument for corner and accessories established to perpetuate locating the position of the corner:

Set 18' long iron pipe with brass plate over brass tablet in monument box and is accepted as a careful and faithful perpetuation of the position of the original corner.

Set nail w/witness tag in Power Pole	N 8°07'	E 165.08'
Set nail w/witness tag in Power Pole	S 7°39'	E 181.73'
NE Corner base Swartz Tombstone	N 83°59'	W 51.70'
SE Corner base Rough Tombstone	N 52°52'	W 65.83'
Found Railroad Spike	N 592.16'	

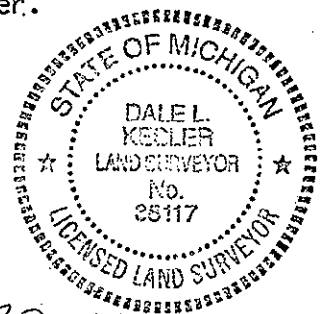

Signed by *Dale L. Kesler* Date November 29, 1995

Surveyor's Michigan License No. 38117