

RAI...ED BY THE BERRIEN COUNTY SURVEY PEER GROUP AS THE OFFICIAL CORNER UNDER MICHIGAN PUBLIC ACT 345 OF 1890

11/29/95 111#2012 A77
 CORNER \$9.00
 11/29/95 111#2012 A77
 STATE REMON FEE \$3.00

BERRIEN COUNTY REMONUMENTATION
LAND CORNER RECORDATION CERTIFICATE
 Filing Requirement of Act 74, Mich. P.A. 1970

4-04-95
 For corners in

BERRIEN (County)	Located In:	Corner Code ##
1. Public Land Survey	T 8S R 19W	A-8
	T R	
	T R	
	T R	
2. Property Controlling in Section	S T R	
	S T R	
3. Miscellaneous Property in Sec.	S T R	
	S T R	
4. Lot No. _____, Recorded Plat _____		
5. Private Claims _____		

RECORDED
 NOV 29 3 11A PM '95
Berrien County
 REGISTER OF DEEDS
 REGISTER OF DEEDS STAMP & FILE NUMBER

I, JOHN G. KAMER, in a field survey on NOVEMBER 17, 19 95, do hereby certify that under requirements of P.A. 74, Michigan P.A. of 1970, the corner points mentioned in lines 1 and 2 above were in conformance with regulations and rules therefore as required in the current manual of survey instructions of the United States Department of the Interior, Bureau of Land Management or by a decree of a Court of Law and/or that the corner points mentioned in lines 3, 4 and 5 above were in conformance with the rules of the Michigan Board of Land Surveyors or by a Decree of a Court of Law, established, re-established, monumented, re-monumented, recovered, found as expressed below:

	A	B	C	D	E	F	G	H	I	J	K	L	M
2	6	5	4	3	2	1							
3													
4	7	8	9	10	11	12							
5													
6	18	17	16	15	14	13							
7													
8	19	20	21	22	23	24							
9													
10	30	29	28	27	26	25							
11													
12	31	32	33	34	35	36							
13													

NOTE: Not more than 4 corners, all in the same town and range, may be recorded on this certificate.

A. Description of original monument and accessories and/or subsequent restoration:
 (SEE BACK.)


STATE OF MICHIGAN
 REMONUMENTATION
 MAR 27 1996
 COMMISSION

B. Description of corner evidence found and/or method applied in restoring or reestablishing corner:
 FOUND RED STONE WITH "X" ON IT.

C. Description of monument for corner and accessories established to perpetuate locating the position of the corner:

REMOVED RED STONE.
 SET STANDARD 3' X 4" CONCRETE MONUMENT WITH BRASS PLATE. ALSO SET CARSONITE MARKER IN VICINITY OF CORNER.
 SET NAIL W/TAG IN FENCE POST NORTH 22.44'
 SET NAIL W/TAG IN 13" CHERRY N 68° E 22.26'
 SET NAIL W/TAG IN 18" BOX ELDER N 30° W 25.47'
 TOP/MIDDLE OF FENCE POST SOUTH 22.73'
 CORNER IS ACCEPTED AS A CAREFUL AND FAITHFUL PERPETUATION OF THE POSITION OF THIS ORIGINAL CORNER.

Signed by John G. Kamer
 Surveyor's Michigan License No. 27449

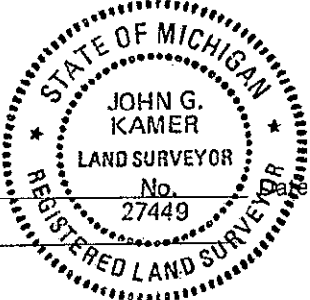

11-29-95

**W ¼ Cor. 19-8-19
A-8
Galien Township**

**Corner Not Set by GLO Surveyors.
GLO Map Shows a 2.20 Chain Jog
at NW Cor. Section 19**

March 7, 1995

**John G. Kamer, Wightman & Associates, Inc.
Found Red Stone
144.78' South of RR Spike at
E ¼ Corner 24-8-20
Accessories:
PK in 13" Cherry N65°E 22.23'
PK in Fence Post South 22.44'
Metal Fence Post North 22.86'
PK in 18" Box Elder N 35°W 25.40'**