

RATIFIED BY THE BERRIEN COUNTY SURVEY PEER GROUP AS THE OFFICIAL CORNER UNDER MICHIGAN PUBLIC ACT 345 OF 1990

RECORDED

Berrien County Remonumentation
LAND CORNER RECORDATION CERTIFICATE
 Filing Requirement of Act 74, Mich. P.A. 1970

SEP 29 11 06 AM '95

Berrien County
 REGISTER OF DEEDS
 BERRIEN COUNTY MICHIGAN

For corners in 6-22-95

Barrien (County)	Located In:	Corner Code #:
1. Public Land Survey	T 8S R 18W	A-5
	T R	
	T R	
	T R	
2. Property Controlling In Section	S T R	
	S T R	
3. Miscellaneous Property in Sec.	S T R	
	S T R	

Register of Deeds Stamp & File Number

4. Lot No. _____, Recorded Plat _____
 5. Private Claims _____

	A	B	C	D	E	F	G	H	I	J	K	L	M
2	6	5	4	3	2	1							
3													
4	7	8	9	10	11	12							
6	18	17	16	15	14	13							
7													
8	19	20	21	22	23	24							
9													
10	30	29	28	27	26	25							
11													
12	31	32	33	34	35	36							
13													

I, Charles W. Barger, in a field survey on August, 19 95, do hereby certify that under requirements of P.A. 74, Michigan P.A. of 1970, the corner points mentioned in lines 1 and 2 above were in conformance with regulations and rules therefore as required in the current manual of survey instructions of the United States Department of the Interior, Bureau of Land Management or by a decree of a Court of Law and/or that the corner points mentioned in lines 3, 4 and 5 above were in conformance with the rules of the Michigan Board of Land Surveyors or by a Decree of a Court of Law; established, re-established, monumented, re-monumented, recovered, found as expressed below:

NOTE: Not more than 4 corners, all in the same town and range, may be recorded on this certificate.

A. Description of original monument and accessories and/or subsequent restoration:

Jul 1829 L. Lyon L.2, P.118-119 Government Notes
 South on East boundary of Sec 12 T8S R19W
 80.00 Set Frost corner to Sec 12 & 13 09/29/95
 Ash 8 N14W 58
 Beech 7 S21W 34 09/29/95

111#7821 A77
 CORNER \$9.00
 111#7821 A77
 STATE REMON FEE \$2.00

B. Description of corner evidence found and/or method applied in restoring or reestablishing corner:

May 1995

C. Barger

Found Berrien County Road Commission Cap
 Found Iron South 33.0'
 Set Witness Tag in PP #B676-14 S. 5°48'E. 36.61'
 Set Witness Tag in PP #B646-33 N. 10°44'W. 85.55'
 Center of Telephone Pedestal N. 12°42'E. 38.43'
 Center of Telephone Pedestal N. 75°47'W. 99.91'
 Found 1-1/4" Iron Rod N. 0°51'W. 34.83' (Bent)

C. Description of monument for corner and accessories established to perpetuate locating the position of the corner:

A-5 1" Pipe 12" Long with 2 1/2" Remonumentation Brass Cap in Monument Box (Over Stone)

Iron South 33.0'
 Witness Tag in PP #B676-14 S. 5°48'E. 36.61'
 Witness Tag in PP #B646-33 N. 10°44'W. 85.55'
 Center of Telephone Pedestal N. 12°42'E. 38.43'
 Center of Telephone Pedestal N. 75°47'W. 99.91'
 1-1/4" Iron Rod N. 0°51'W. 34.83' (Bent)


And is accepted as a careful and faithful perpetuation of the position of the original corner.

Signed by Charles W. Barger

Date September 28, 1995

Surveyor's Michigan License No. 31589

FORM APPROVED BY MICHIGAN STATE BOARD OF LAND SURVEYORS, JAN. 28, 1971
 REVISED MAY 14, 1975
 REVISED JAN., 1983

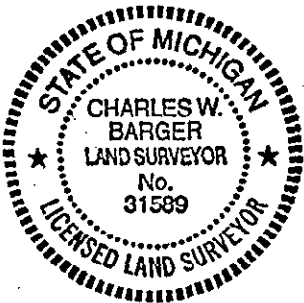

NORTHWEST CORNER SECTION 18-8-18

SOUTHWEST CORNER SECTION 7-8-18

95512.05

(Bertrand Township - Buffalo & Mt. Zion Rd)

Jul 1829

L. Lyon L. 2, P. 118-19 Government Notes

South on East boundary of Sec 12 T8S R19W

80.00 Set frost corner to Secs 12 & 13

Ash 8 N14W 58

Beech 7 S21W 34

Feb 1830

L. Lyon L. 2, P. 122 Government Notes

West on random between 7 & 18

79.98 Intersected W. Boundary 20 lks South of post

East Corrected the line between 7 & 18

UNKNOWN

Berrien County Road Commission

Cap

Iron South 33.0'

6" Ash N 70° W 45.3'

16" Chestnut SW 85.2'

Iron N. 33'

UNKNOWN

R. Prestine

Plug by B.C.R.C.

1/2" Iron bar S. 5° E. 33.8'

Face R.R. Tie cor. post North 46.75'

Center of E. Pole S. 2° E. 36.6'

Center of 48" Pine S. 56° W. 98.4'

May, 1995

C. Barger

Found BCRC Cap

Found Iron South 33.0'

Set Witness Tag in PP #B676-14 S. 5° 48' E. 36.61'

Set Witness Tag in PP #B646-33 N. 10° 44' W. 85.55'

Center of Telephone Pedestal N. 12° 42' E. 38.43'

Center of Telephone Pedestal N. 75° 47' W. 99.91'

Found 1 1/4" Iron Rod N. 0° 51' W. 34.83' (Bent)

SURVEY &
RECONSTITUTION

NOV 1 1995

COMMISSION

LIBER

3 PAGE 249